IREDELL COUNTY HEALTH DEPARTMENT

STATESVILLE 704-878-5305 MOORESVILLE 704-664-5281

IMPROVEMENT PERMIT / AUTHORIZATION TO CONSTRUCT / OPERATION PERMIT / EXISTING SYSTEM INSPECTION

PERMIT# 153068 PIN# 4655645914.000 DATE 10/14/08

OWNER OR APPLICANT CMH Homes - William Cline PHONE: Business 704 746-4778 Home

ADDRESS 1042 Charlotte Hwy Troutman, NC 28166

LOCATION Faith Rd. on Left past English Hills Next to 409 Faith Rd.

SUBDIVISION N/A Cline BLOCK / SECTION LOT 1 LOT AREA ≈ 2 acres SITE CLASS. PS DESIGN FLOW 360 L.T.A.R. .3

Septic Tank: 1000 Gallons; STB 794 Date 8/8/08

Pump Tank: Gallons; PT Date

Pump Make: Model Serial No.

Nitrification Field: No Fields 1 Square Feet Eq to 1200 Linear Feet 300'

No Lines 3@100' Trench Width 36" Max Trench Bottom Depth 36"

☑ New System ☐ Repair ☐ Expansion System Type: I (II) III IV V VI

System Description: Gravity 25% Reduction

Repair System Description: Pump/Gravity 25%

Maintenance Agreement Required: ☐ Yes ☑ No

☑ House/Mod. Home No. Bedrooms 3

☐ Mobile Home No. Persons

☐ Business No. Employees

☐ Other

Water Supply: ☑ Individual ☐ Public ☐ Community


Gravel Depth N/A ☐ Gravity ☑ Pressure ☐ Slab ☑ Crawl Space ☐ Basement w/plumbing ☐ Basement wo/plumbing

Comments:/Conditions:


Comments:/Conditions: Use D-box w/ flow levelers or approved method of Serial Distribution.

Scale 1" = 50'

INITIAL SITE SKETCH

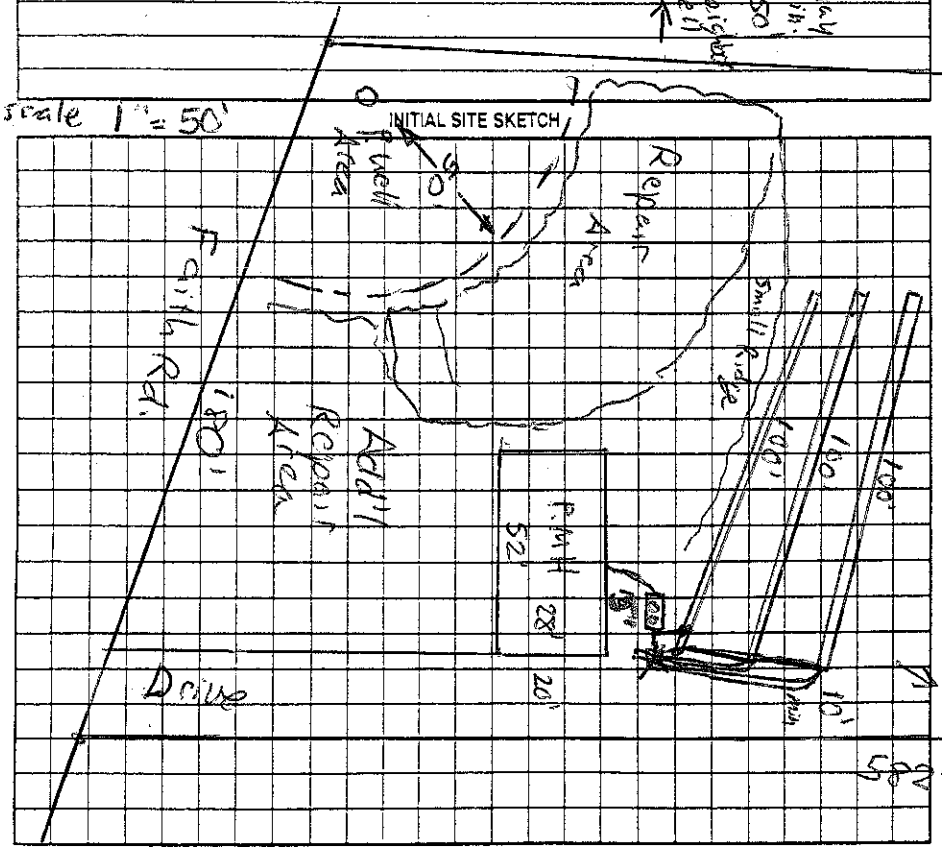

AS BUILT SKETCH

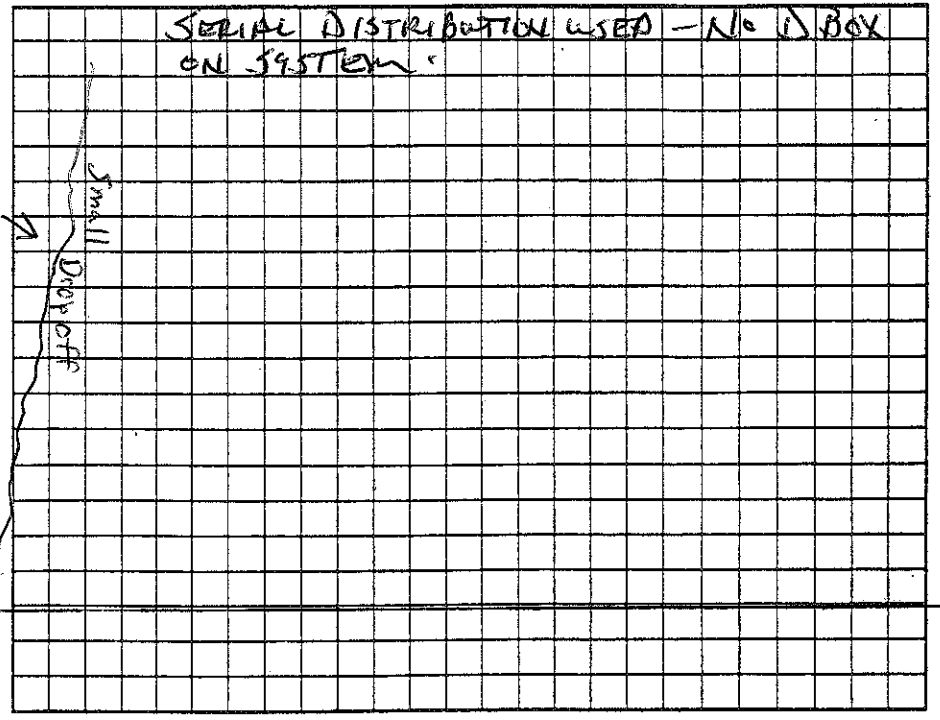

Permit can be suspended or revoked if any false information is supplied toward securing the permit/any unauthorized changes are made to the site/any unauthorized changes are made in the installation of the system. Improvement Permit with plat valid without expiration ☐ Improvement Permit with site plan valid for sixty months ☑ Authorization to Construct is valid for a period equal to that of Improvement Permit – not to exceed sixty months.

Signed: [signature] date 10-16-08 Installed by: A-1 Backhoe

Improvement Permit by: Anthony Cole jr. R.S. date 10/14/08 Operation Permit by: Wesley Sparks R.S. date 10/20/08

Authorization to Construct by: Anthony Cole jr R.S. date 10/15/08 Existing System Inspection by: date

HEALTH DEPT. COPY: WHITE OWNER COPY (FINAL): YELLOW OWNER COPY (INITIAL): PINK