4055653214

IREDELL COUNTY HEALTH DEPARTMENT

STATESVILLE 704-878-5305 MOORESVILLE 704-664-5281

2.0

IMPROVEMENT PERMIT / CERTIFICATE OF COMPLETION / OPERATION PERMIT / EXISTING SYSTEM INSPECTION

PROPERTY DESCRIPTION NO. 20741 DATE 4/24/95 TAX MAP NO. 10 C 125 Watershed: ☐ Yes ☑ No

OWNER OR CONTRACTOR Rick Franzak PHONE: Business _____ Home 664-2982

ADDRESS 310 Murdock St. Mooresville, NC. 28115

LOCATION Faith Rd. ~ Inside on ① just past English Hills

SUBDIVISION N/A BLOCK / SECTION N/A LOT N/A LOT AREA ~2.48 Ac SITE CLASS. P DESIGN FLOW 360 L.T.A.R. .3

Septic Tank: 1000 Gallons; STB 794 Date 5/10/96

Pump Tank: _____ Gallons; PT _____ Date _____

Pump Make: _____ Model _____ Serial No. _____

Nitrification Field: No Fields 1 Square Feet 1200 Linear Feet 400

No Lines 4 Trench Width 36" Max Trench Bottom Depth 36" Gravel Depth 36"

☑ New System ☐ Repair System Type: I, II, III, IV, V, VI

System Description: GRAVITY - CONV.

Repair System Description: SAME

Maintenance Agreement Required: ☐ Yes ☑ No

☑ House/Mod. Home No. Bedrooms 3

☐ Mobile Home No. Bathrooms 2.5

☐ Business No. Employees ____

☐ Other _____


☐ Slab ☐ Crawl Space ☑ Basement w/plumbing ☐ Basement wo/plumbing

Water Supply: ☑ Individual ☐ Community ☐ Public


Comments: Lines on contour - Dist Box w/ 4 speed Leveler.

Comments: Everything checked on 5/14/96. Approved when tank is 28 days old. Tank was not 3500 psi.

INITIAL SITE SKETCH

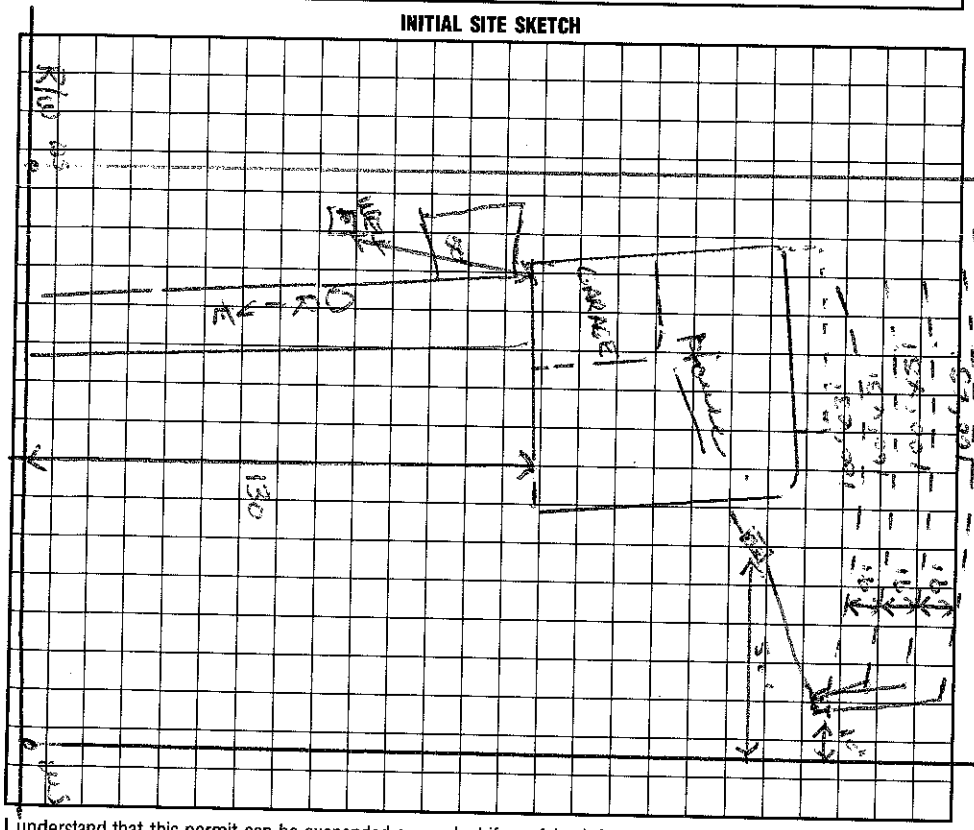

AS BUILT SKETCH

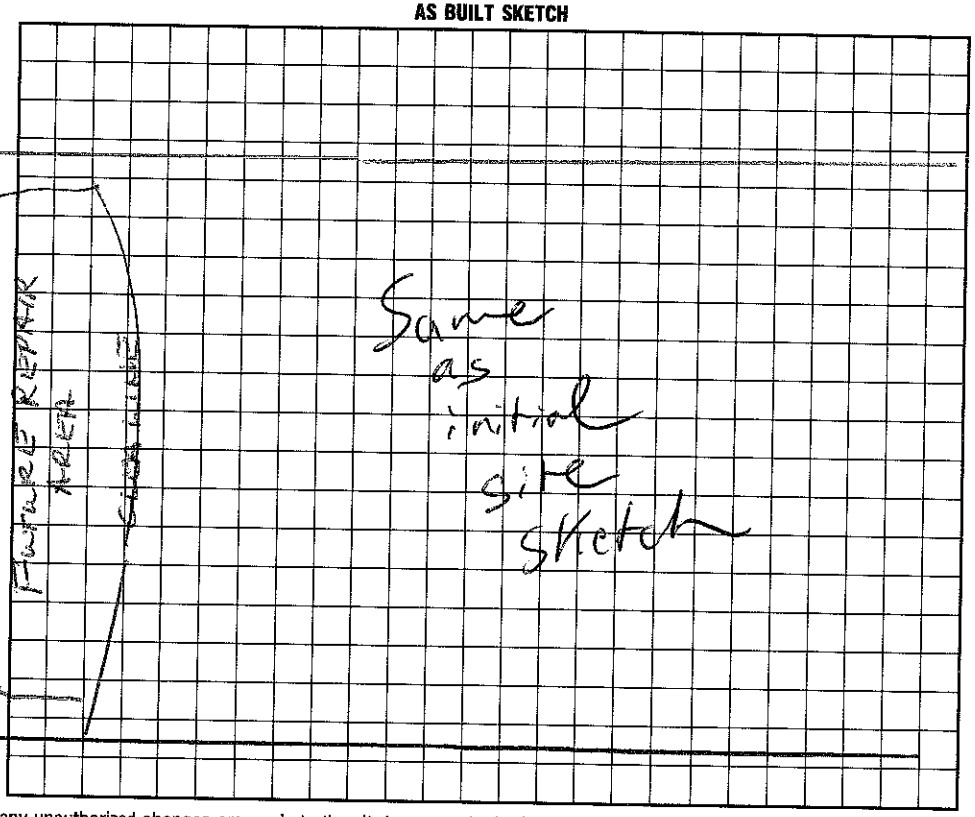

I understand that this permit can be suspended or revoked if any false information is supplied toward securing the permit/any unauthorized changes are made to the site/any unauthorized changes are made in the installation of the system. Improvement Permit is valid for 60 months from date of issuance.

Signed: x Rick Franzak

Improvement Permit by: Wesley Sparks RS. date 4/24/95

Existing System Inspection by: _____ date _____

Installed by: Wayne Orbison

Certificate of Completion by: _____ date _____

Operation Permit by: C. Mark Foster EH SE date 6/7/96

HEALTH DEPT. COPY: WHITE INSPECTION COPY (FINAL): GREEN OWNER COPY (FINAL): YELLOW INSPECTION COPY (INITIAL): PINK OWNER COPY (INITIAL): GOLD