IREDELL COUNTY HEALTH DEPARTMENT

Authorization to Construct

STATESVILLE 704-878-5305 MOORESVILLE 704-664-5281

PIN# 4655-65-7549

IMPROVEMENT PERMIT / CERTIFICATE OF COMPLETION / OPERATION PERMIT / EXISTING SYSTEM INSPECTION

PROPERTY DESCRIPTION NO. 18666 DATE 3/8/96 TAX MAP NO. ID A 44 Pt of Watershed: [X] Yes [ ] No

OWNER OR CONTRACTOR Curtis Alan Wheat PHONE: Business _____ Home _____

ADDRESS PO Box 213 Mt. Mourne, NC. 28123

LOCATION English Hills - Faith Rd TL English Hills TR Wood Acres Circle on (R) 5th lot on (R)

SUBDIVISION English Hills BLOCK / SECTION III LOT 26 LOT AREA ~ 1.3 AC SITE CLASS. PS DESIGN FLOW 360 L.T.A.R. .25

Septic Tank: 1000 Gallons; STB 794 Date 2/29/96

Pump Tank: _____ Gallons; PT _____ Date _____

Pump Make: _____ Model _____ Serial No. _____

Nitrification Field: No. Fields 1 Square Feet 1440 Linear Feet *240

No Lines @ 4 Trench Width 24" Max Trench Bottom Depth 30" Gravel Depth 6" SAND

[X] New System [ ] Repair System Type: I, II, (III), IV, V, VI

System Description: Gravity - Panel Block 16"

Repair System Description: Same

Maintenance Agreement Required: [ ] Yes [X] No

[X] House/Mod. Home No. Bedrooms 3

[ ] Mobile Home No. Bathrooms 2

[ ] Business No. Employees _____

[ ] Other _____


[ ] Slab [X] Crawl Space [ ] Basement w/plumbing [ ] Basement wo/plumbing

Water Supply: [X] Individual [ ] Community [ ] Public


Comments:

Comments:

INITIAL SITE SKETCH

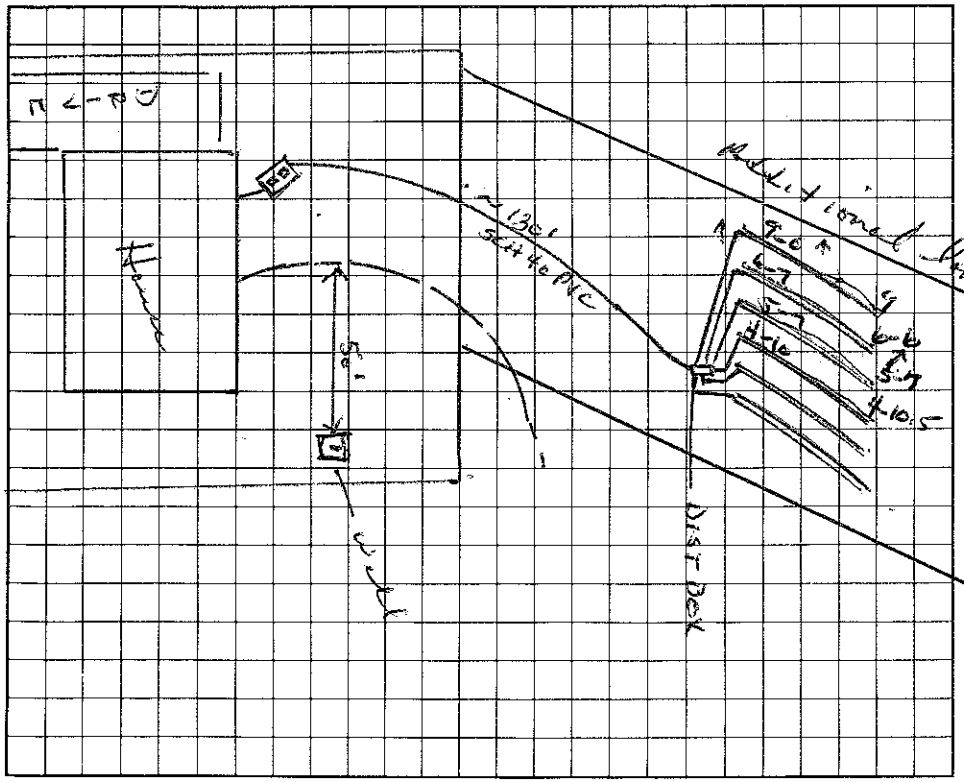

AS BUILT SKETCH

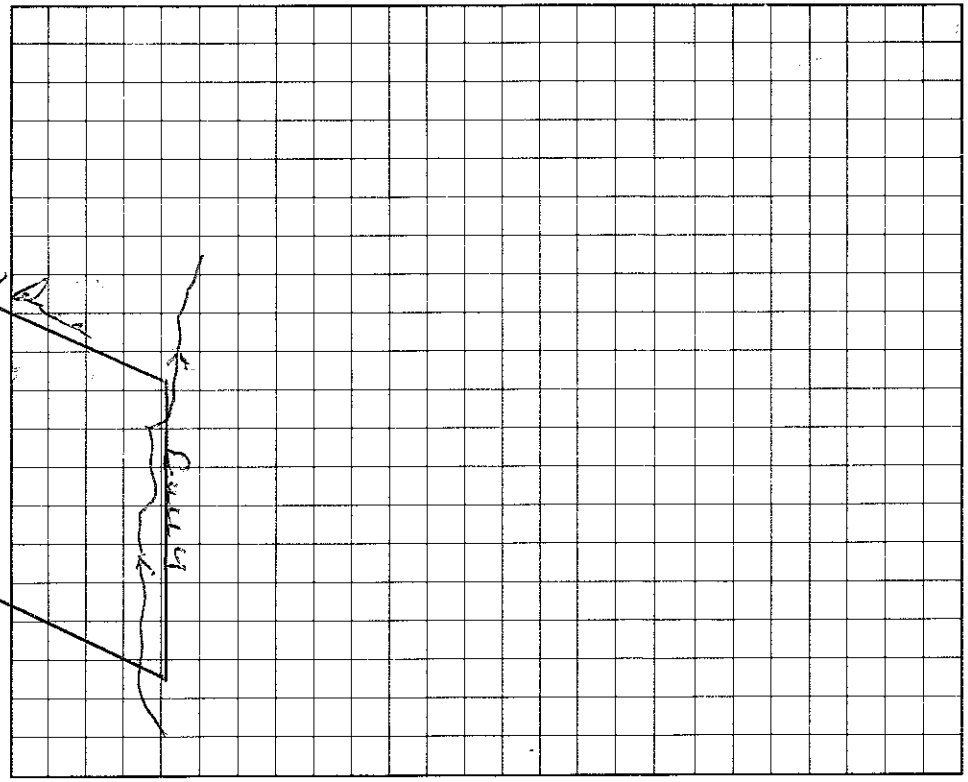

I understand that this permit can be suspended or revoked if any false information is supplied toward securing the permit/any unauthorized changes are made to the site/any unauthorized changes are made in the installation of the system.

Signed: Authorization to Construct valid for 5 years Curtis B. Wheat

Improvement Permit by: Wesley Sparks R.S. date 3/8/96

Existing System Inspection by: Wesley Sparks R.S. date 3/8/96

Installed by: Richard Abernathey

Certificate of Completion by: _____ date _____

Operation Permit by: Wesley Sparks R.S. date 4/8/96

HEALTH DEPT. COPY: WHITE INSPECTION COPY (FINAL): GREEN OWNER COPY (FINAL): YELLOW INSPECTION COPY (INITIAL): PINK OWNER COPY (INITIAL): GOLD