4655697762

# IREDELL COUNTY HEALTH DEPARTMENT

STATESVILLE 704-878-5305 MOORESVILLE 704-664-5281

## IMPROVEMENT PERMIT / CERTIFICATE OF COMPLETION / OPERATION PERMIT / EXISTING SYSTEM INSPECTION

PROPERTY DESCRIPTION NO. 065687 DATE 3/31/97 TAX MAP NO. 4656987764 Watershed: ☐ Yes ☒ No

OWNER OR CONTRACTOR F.T. Irwin PHONE: Business 664-5418 Home

ADDRESS Brianfield Rd. Mooresville, NC. 28115

LOCATION Mockingbird Rd TR on Brianfield Rd, 2nd spot on L

SUBDIVISION N/A BLOCK / SECTION LOT LOT AREA 2 acres SITE CLASS. DESIGN FLOW 240 L.T.A.R.

Septic Tank: Existing Gallons; STB Date

Pump Tank: Gallons; PT Date

Pump Make: Model Serial No.

Nitrification Field: No Fields Square Feet Existing System ~~Linear Feet~~

No Lines Trench Width Max Trench Bottom Depth Gravel Depth

☐ New System ☐ Repair System Type: I, II, III, IV, V, VI

System Description: Existing System.

Repair System Description:

Maintenance Agreement Required: ☐ Yes ☒ No

☐ House/Mod. Home ☒ Mobile Home ☐ Business ☐ Other

No. Bedrooms 2 No. Bathrooms 2 No. Employees

☐ Slab ☐ Crawl Space ☐ Basement w/plumbing ☐ Basement wo/plumbing


Water Supply: ☒ Individual ☐ Community ☐ Public

Comments:

Comments:

**INITIAL SITE SKETCH**

**AS BUILT SKETCH**

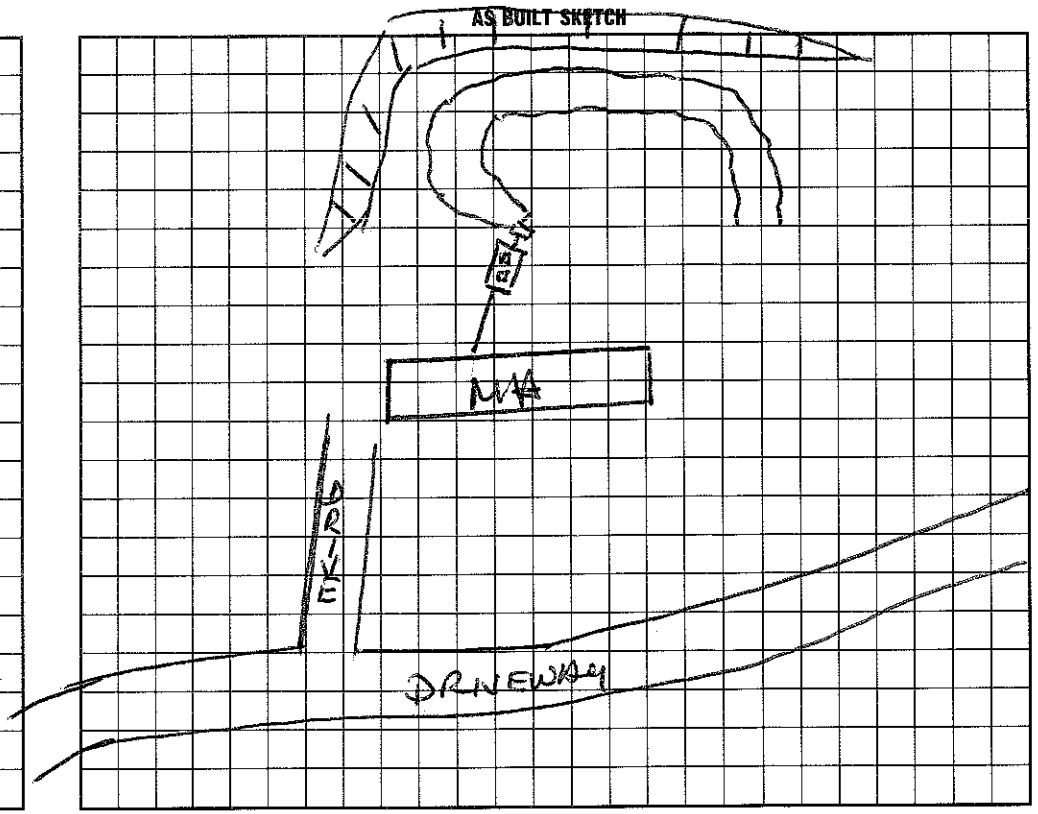


I understand that this permit can be suspended or revoked if any false information is supplied toward securing the permit/any unauthorized changes are made to the site/any unauthorized changes are made in the installation of the system. Improvement Permit is valid for 60 months from date of issuance.

Signed:

Improvement Permit by: date

Existing System Inspection by: date

Installed by:

~~Certificate of Completion by:~~ Existing System; Wesley Sparks R.S. date 3/31/97

Operation Permit by: Wesley Sparks R.S. date 3/31/97

HEALTH DEPT. COPY: WHITE INSPECTION COPY (FINAL): GREEN OWNER COPY (FINAL): YELLOW INSPECTION COPY (INITIAL): PINK OWNER COPY (INITIAL): GOLD