4655 69 9725

IREDELL COUNTY HEALTH DEPARTMENT

STATESVILLE 704-878-5305 MOORESVILLE 704-664-5281

IMPROVEMENT PERMIT / AUTHORIZATION TO CONSTRUCT / OPERATION PERMIT / EXISTING SYSTEM INSPECTION

PERMIT # 164357 PIN # 4655698769 DATE 12-14-10

OWNER or APPLICANT FJ Ervin PHONE: Business 664-5418 Home: Cell 704 361-4975

OWNER or APPLICANT ADDRESS 380 Mackwood Mooresville, NC 28115

LOCATION / DIRECTIONS Hwy 115 South TL Mackwood ~3/4 mile on right (past Saddle & Gas line ROW)

SUBDIVISION BLOCK / SECTION LOT # LOT AREA 3AC DESIGN FLOW 360gpd L.T.A.R. #330

EXIST

Septic Tank 1000 Gallons: STB Date

Pump Tank Gallons: P T Date

Pump Make Model Serial #

Nitrification Field No Fields 1 No Lines 6 Linear Feet 250'+

Trench Width 36"+ Bed Max. Trench Bottom Depth 36" Gravel Depth 12"+

☐ New System ☐ Repair ☐ Expansion System Type I II III IV V VI

System Description Exist Grav Convent 25% Reduct.

Repair System Description: Modified Conv.

Maintenance Agreement Required ☐ YES ☒ NO

☒ GRAVITY ☐ PRESSURE


☒ Residence No. Bedrooms 3 ☐ Business No. Persons ☐ Other No. Employees ☐ Slab ☒ Crawl Space ☐ Basement w/plumbing ☐ Basement w/o plumbing

Water Supply: ☒ Private ☐ Public ☐ Community


Comments / Conditions: 4 lines in Bed, 2 lines in trenches Graveled Plastic Chambers

Comments / Conditions: Existing Septic System appears to be functioning okay at time of inspection Keep Waters 25ft from well & 5ft from Septic

INITIAL SITE SKETCH

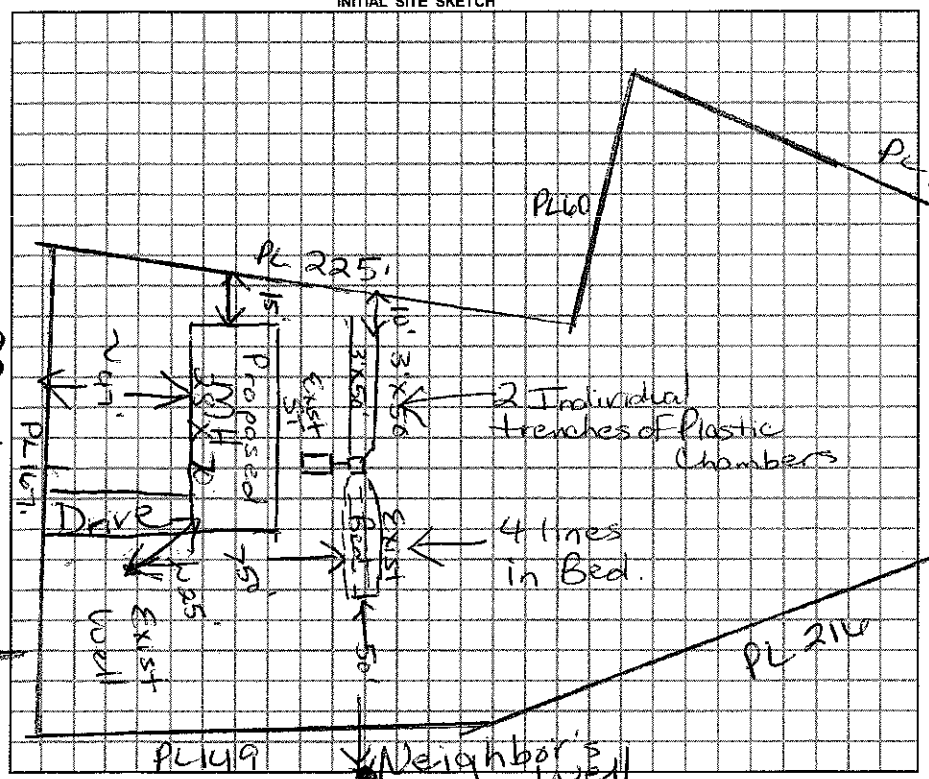

AS BUILT SKETCH

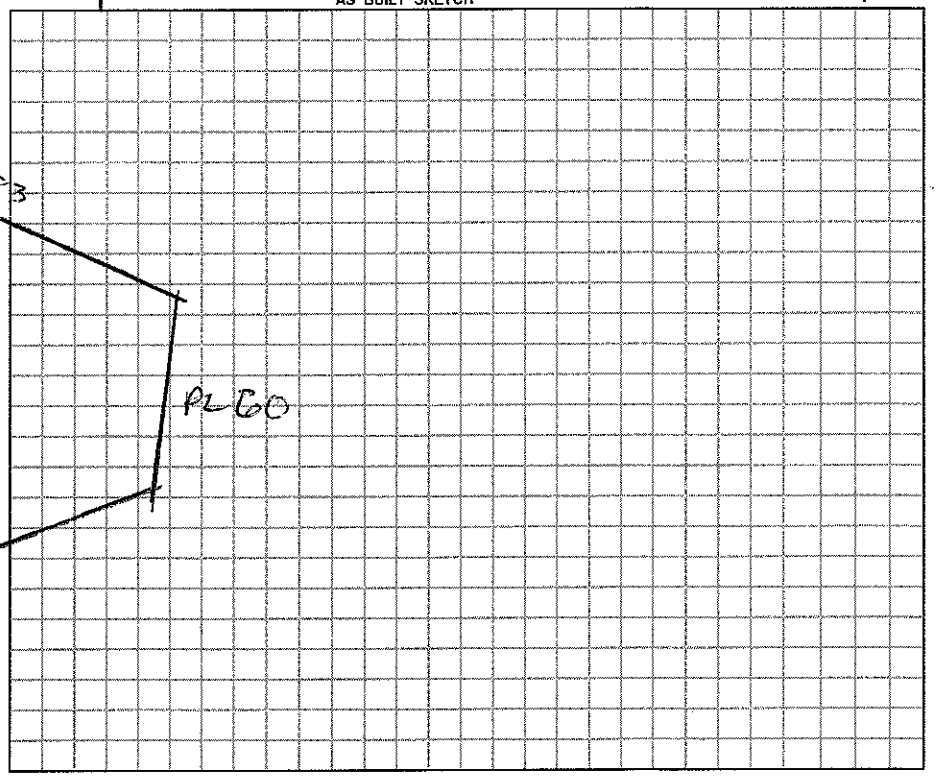

Permit can be suspended or revoked if any false information is supplied toward securing the permit / any unauthorized changes are made to the site / any unauthorized changes are made in the installation of the system.

☐ *IMPROVEMENT PERMIT w / plat valid without expiration* ☐ *IMPROVEMENT PERMIT w / site plan valid for 60 mos.* ☐ *AUTHORIZATION TO CONSTRUCT valid for period equal to IMPROVEMENT PERMIT-not to exceed 60 mo.*

Owner / Applicant Signature: X FJ Ervin Date 12-14-10 Installed by: FJ Ervin

Improvement Permit by: Date

Authorization to Construct by: Date

Operation Permit by: Date:

Existing System Inspected by: Marie H. Dolan RS Date: 12/14/2010

YOU SHOULD CONTACT A LOCATOR SERVICE PRIOR TO ANY EXCAVATION.

WHITE COPY Environmental Health YELLOW COPY (Final) Owner / Applicant PINK COPY (Initial) Owner / Applicant