IREDELL COUNTY HEALTH DEPARTMENT

STATESVILLE 704-878-5305 MOORESVILLE 704-664-5281

IMPROVEMENT PERMIT / CERTIFICATE OF COMPLETION / OPERATION PERMIT / EXISTING SYSTEM INSPECTION

PROPERTY DESCRIPTION NO. 19033 DATE 6/22/94 TAX MAP NO. 1C 9A 6 4655-10-0092 Watershed: ☐ Yes ☑ No

OWNER OR CONTRACTOR WALTER BARTON PHONE: Business 892-6933 Home

ADDRESS 135 BERACAH PLACE

LOCATION MIDWAY LAKE RD. R ON BERACAH 8th lot on (R)

SUBDIVISION BERACAH PLACE BLOCK / SECTION 1 LOT 6 LOT AREA 1.01 AC. SITE CLASS. P DESIGN FLOW 360 L.T.A.R. .25-.3

Septic Tank: 1000 Gallons; STB 794 Date 11/5/94

Pump Tank: Gallons; PT Date

Pump Make: Model Serial No.

Nitrification Field: No Fields 1 Square Feet ~~700~~ 1200 Linear Feet 400

No Lines 4-5 Trench Width 36" Max Trench Bottom Depth 32" Gravel Depth 12"

☑ New System ☐ Repair System Type: I, (II), III, IV, V, VI

System Description: DROPBOX - CONVENTIONAL

Repair System Description: PRES. PANEL

Maintenance Agreement Required: ☐ Yes ☑ No

☑ House/Mod. Home No. Bedrooms 3

☐ Mobile Home No. Bathrooms 2.5

☐ Business No. Employees

☐ Other


☐ Slab ☐ Crawl Space ☐ Basement w/plumbing ☑ Basement wo/plumbing

Water Supply: ☑ Individual ☐ Community ☐ Public

Comments: Diversion Ditch Constructed before installation. 15' from diversion ditch at closest point.

Comments: installed as shown.

INITIAL SITE SKETCH

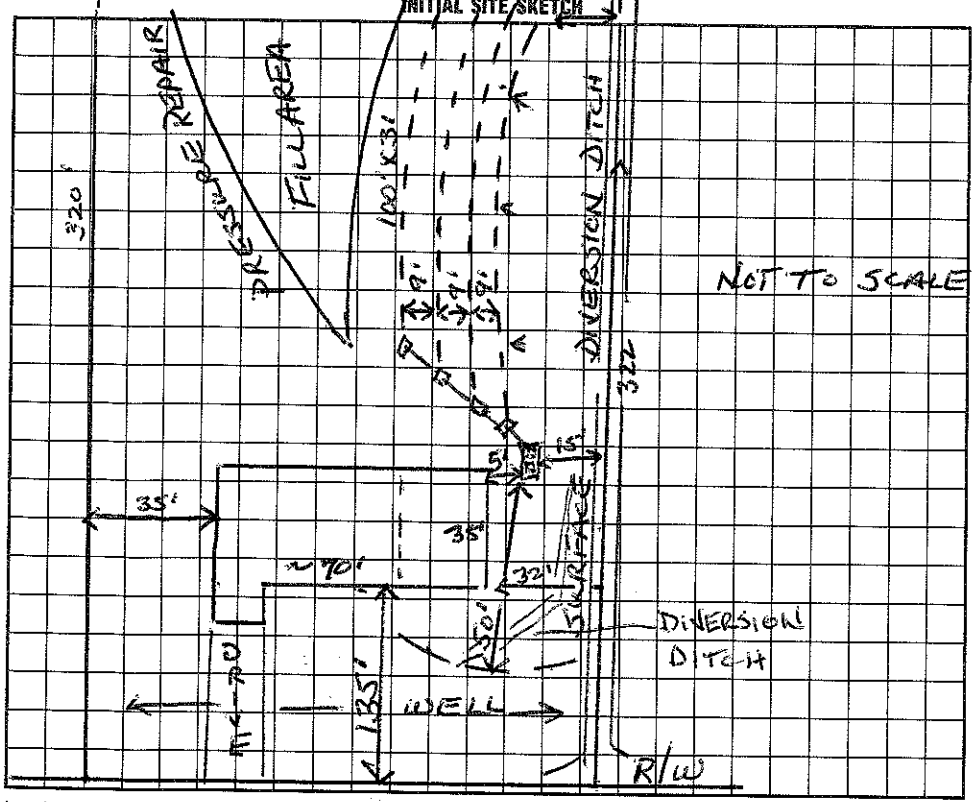

AS BUILT SKETCH

I understand that this permit can be suspended or revoked if any false information is supplied toward securing the permit/any unauthorized changes are made to the site/any unauthorized changes are made in the installation of the system. Improvement Permit is valid for 60 months from date of issuance.

Signed: X Walter Barton BERACAH PL.

Improvement Permit by: Wesley Sparks RS. date 6/22/94

Existing System Inspection by: date

Installed by: Curt Dunning

Certificate of Completion by: Wesley Sparks RS. date 3/24/95

Operation Permit by: date

HEALTH DEPT. COPY: WHITE INSPECTION COPY (FINAL): GREEN OWNER COPY (FINAL): YELLOW INSPECTION COPY (INITIAL): PINK OWNER COPY (INITIAL): GOLD