IREDELL COUNTY HEALTH DEPARTMENT

→ Authorization to Construct PIN# 4655-70-0092

STATESVILLE 704-878-5305 MOORESVILLE 704-664-5281

IMPROVEMENT PERMIT / ~~CERTIFICATE OF COMPLETION~~ / OPERATION PERMIT / EXISTING SYSTEM INSPECTION

PROPERTY DESCRIPTION NO. 22675 DATE 3/15/96 TAX MAP NO. IC-9-4-23 Watershed: ☐ Yes ☑ No

OWNER OR CONTRACTOR Donald Price PHONE: Business _____ Home 948-1966

ADDRESS 901 Hunters Rd Huntersville NC

LOCATION Faith Rd - E TR - Midway Lake Rd - TL Beracah Rd - 3rd Lot on Left

SUBDIVISION Beracah Place BLOCK / SECTION _____ LOT 23 LOT AREA 335x165x95 SITE CLASS PS DESIGN FLOW 360gpd L.T.A.R. .13gpd/sqft

Septic Tank: 1000 Gallons; STB 794 Date 6/11/96

Pump Tank: _____ Gallons; PT _____ Date _____

Pump Make: _____ Model _____ Serial No. _____

Nitrification Field: No Fields 1 Square Feet 1200 Linear Feet 400

No Lines 4 Trench Width 36" Max Trench Bottom Depth 36" Gravel Depth 12"

☑ New System ☐ Repair System Type: I II III IV V VI

System Description: Gravity Conventional

Repair System Description: Gravity Chambered

Maintenance Agreement Required: ☐ Yes ☑ No

☐ Slab ☑ Crawl Space ☐ Basement w/plumbing ☐ Basement wo/plumbing

☑ House/Mod. Home No. Bedrooms 3

☐ Mobile Home No. Bathrooms 2

☐ Business No. Employees _____


☐ Other _____

Water Supply: ☑ Individual ☐ Community ☐ Public


Comments:

Comments: Drop Box needed

INITIAL SITE SKETCH

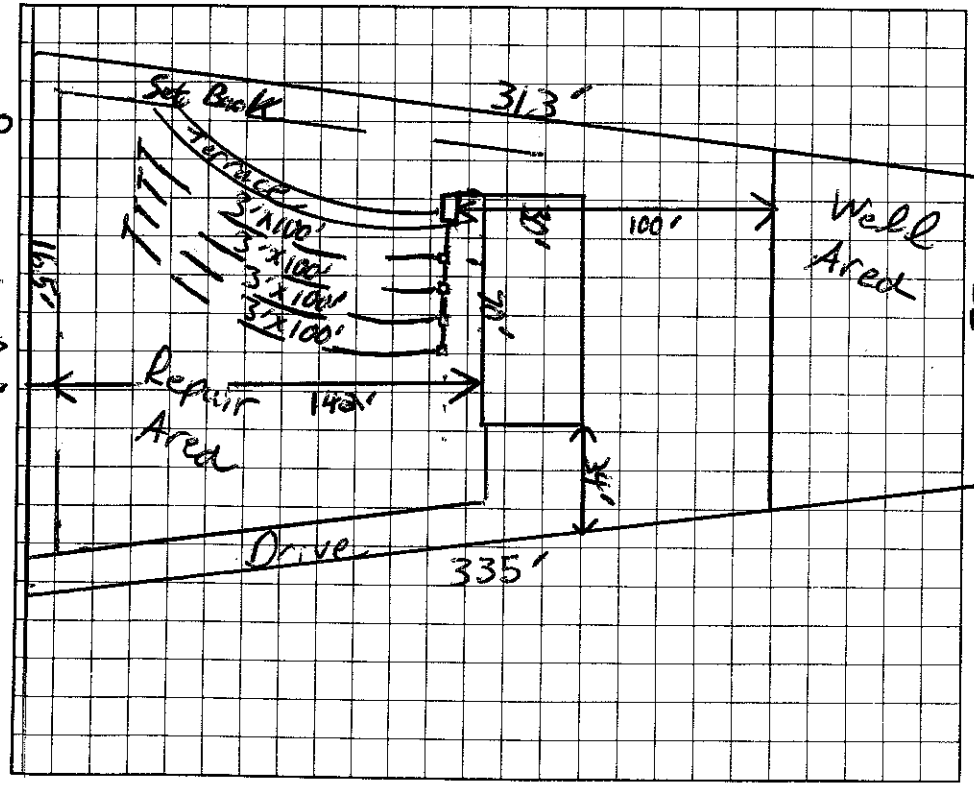

AS BUILT SKETCH

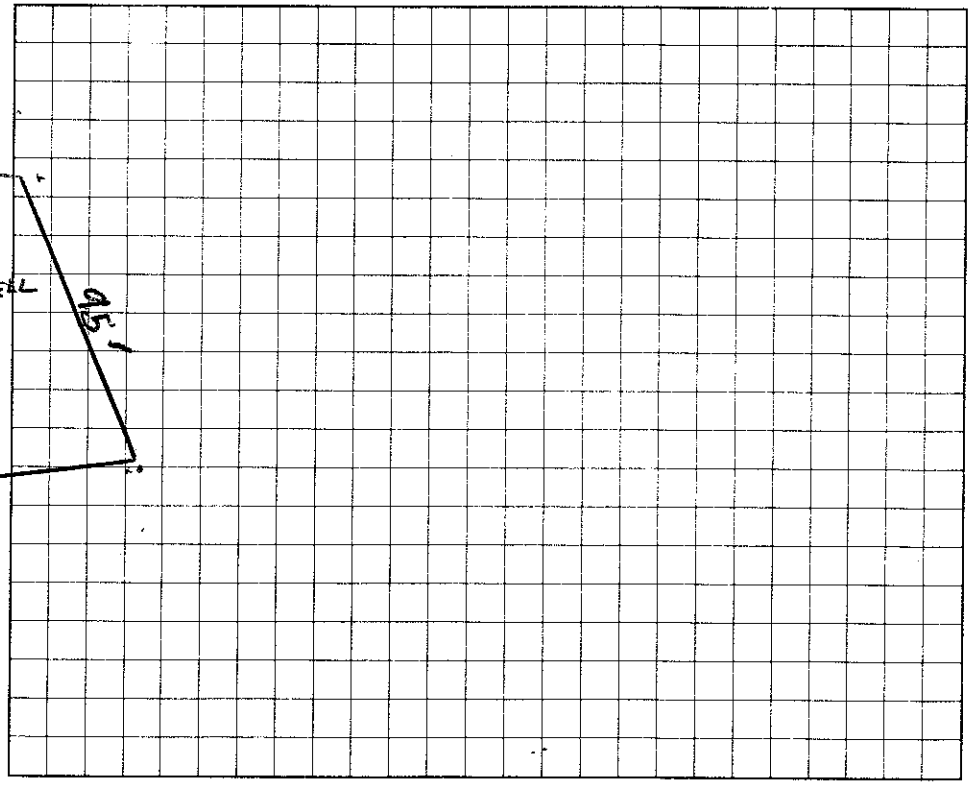

I understand that this permit can be suspended or revoked if any false information is supplied toward securing the permit/any unauthorized changes are made to the site/any unauthorized changes are made in the installation of the system.

Signed: _____

Improvement Permit by: Bobby Keen EHSD date 3/16/96

Authorization to Construct by: Bobby Keen EHSD date 3/16/96

Existing System Inspection by: _____ date _____

Installed by: F J Erwin

Certificate of Completion by: _____ date _____

Operation Permit by: Wesley Sparks RS date 8/13/96

HEALTH DEPT. COPY: WHITE INSPECTION COPY (FINAL): GREEN OWNER COPY (FINAL): YELLOW INSPECTION COPY (INITIAL): PINK OWNER COPY (INITIAL): GOLD

Authorization to Construct is valid for 60 months from issue date.