PIN# 4655-70-8226

IREDELL COUNTY HEALTH DEPARTMENT

STATESVILLE 704-878-5305 MOORESVILLE 704-664-5281

IMPROVEMENT PERMIT / CERTIFICATE OF COMPLETION / OPERATION PERMIT / EXISTING SYSTEM INSPECTION

PROPERTY DESCRIPTION NO. 20174 DATE 2/2/95 TAX MAP NO. IC 9A 19 Watershed: ☐ Yes ☒ No

OWNER OR CONTRACTOR ~~Tom R. Mahaffey~~ GERALD RAY AWS PHONE: Business _____ Home 542-0062

ADDRESS 5909 Ryder Ave Charlotte, NC. 28226

LOCATION Midway Lake Rd (R) onto Barnacle Pl. ~ 2/3 way toward cul de sac on (L)

SUBDIVISION Barnacle Place BLOCK / SECTION _____ LOT 19-3 LOT AREA ~ SITE CLASS. P DESIGN FLOW 360 L.T.A.R. .3

Septic Tank: 1000 Gallons; STB 1012 Tp Date 11-11-95
Pump Tank: _____ Gallons; PT _____ Date _____
Pump Make: _____ Model _____ Serial No. ~~X~~ 300 AWS
Nitrification Field: No Fields 1 Square Feet 1200 Linear Feet (400)
No Lines ~~5~~ 4 Trench Width 36" Max Trench Bottom Depth 36" Gravel Depth 12"

☒ New System ☐ Repair System Type: I, (II), III, IV, V, VI
System Description: ~~INFILTRATOR~~ Drop Boxes AWS
Repair System Description: SAME
Maintenance Agreement Required: ☐ Yes ☒ No
☐ Slab ☒ Crawl Space ☐ Basement w/plumbing ☐ Basement wo/plumbing


☒ House/Mod. Home No. Bedrooms 3
☐ Mobile Home No. Bathrooms 2.5
☐ Business No. Employees _____
☐ Other _____

Water Supply:
☒ Individual
☐ Community
☐ Public


Comments: ~~X~~ 300 (25% reduction) for infiltrators on drop boxes at contours 50' 66' x 3' 6/8/95 AWS

Comments: ENTERED

INITIAL SITE SKETCH

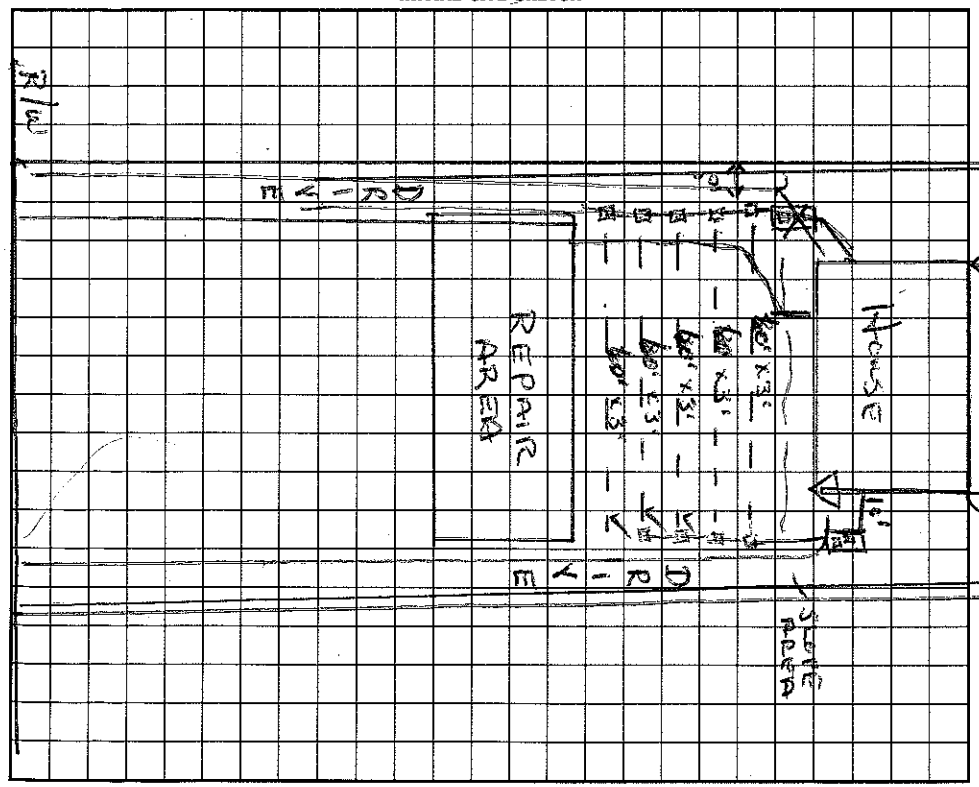

AS BUILT SKETCH

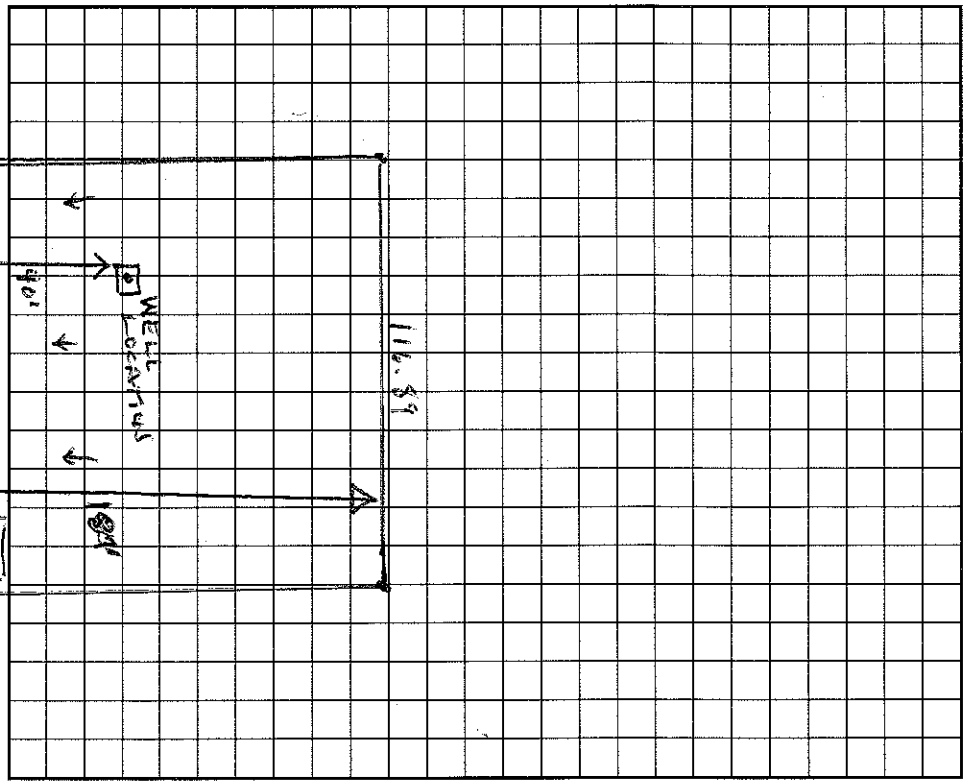

I understand that this permit can be suspended or revoked if any false information is supplied toward securing the permit/any unauthorized changes are made to the site/any unauthorized changes are made in the installation of the system. Improvement Permit is valid for 60 months from date of issuance.

Signed: X William T. Mahaffey

Improvement Permit by: Wesley Sparks RS. date 2/2/95

Existing System Inspection by: _____ date _____

Installed by: Richard Abernathy

Certificate of Completion by: Wesley Sparks R.S. date 2/19/96

Operation Permit by: Wesley Sparks R.S. date 2/19/96

HEALTH DEPT. COPY: WHITE INSPECTION COPY (FINAL): GREEN OWNER COPY (FINAL): YELLOW INSPECTION COPY (INITIAL): PINK OWNER COPY (INITIAL): GOLD