IREDELL COUNTY HEALTH DEPARTMENT

PIN# 4655-70-9282 50.00 Paid 2130

STATESVILLE 704-878-5305 MOORESVILLE 704-664-5281

IMPROVEMENT PERMIT / AUTHORIZATION TO CONSTRUCT / OPERATION PERMIT / EXISTING SYSTEM INSPECTION

PERMIT# 089181 PIN# 4655 70 9282 DATE 4-11-2001

OWNER OR CONTRACTOR Steve & Jennifer Robbins PHONE: Business (704) 875-3780 Jennifer Home 596-5360 (Nextel)

ADDRESS 14017 Kedleston Rd. Huntersville NC 28078

LOCATION Hwy 115 S. TR Midway LK TR Beracah Place lot on left

SUBDIVISION Beracah Place BLOCK / SECTION ____ LOT 18 LOT AREA 1.85 Acre SITE CLASS. PS DESIGN FLOW 360 gpd L.T.A.R. .3

Septic Tank: 1000 Gallons; STB 1000 T Date 1-30-01
Pump Tank: ____ Gallons; PT ____ Date ____
Pump Make: ____ Model ____ Serial No. ____
Nitrification Field: No Fields 1 Square Feet 900' Linear Feet 300'
No Lines 3 @ 100' Trench Width 36" Max Trench Bottom Depth 36" Gravel Depth N/A

[X] New System [ ] Repair System Type: I (II) III IV V VI
System Description: Gravity - 25% Reduction
Repair System Description: Same
Maintenance Agreement Required: [ ] Yes [ ] No


[X] House/Mod. Home No. Bedrooms 3
[ ] Mobile Home No. Bathrooms 2.5
[ ] Business No. Employees ____
[ ] Other ____
[ ] Slab [X] Crawl Space [ ] Basement w/plumbing [ ] Basement wo/plumbing

Water Supply: [X] Individual [ ] Public [ ] Community


Comments/Conditions: Keep Septic System at least 10' from PL, 5' From house & 100' from well (Okay to install 4-75' lines instead 7/5/2001 OK to move ST to right side of house.

Comments/Conditions: Polylok Filter installed

INITIAL SITE SKETCH Scale 1:60' PL 337.3

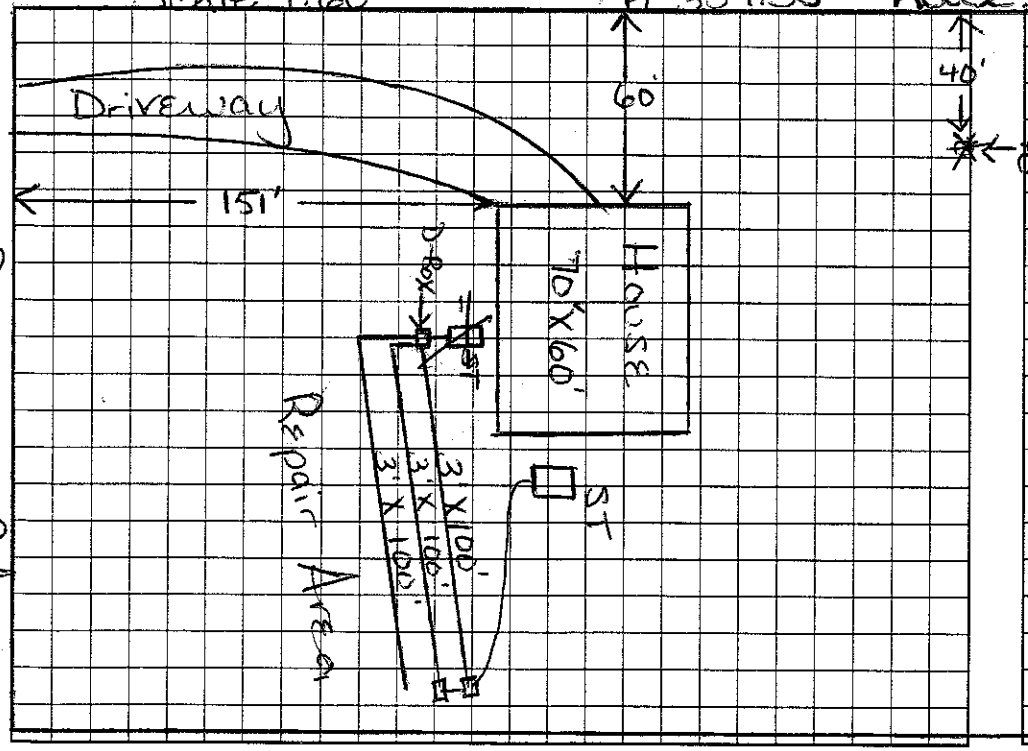

AS BUILT SKETCH

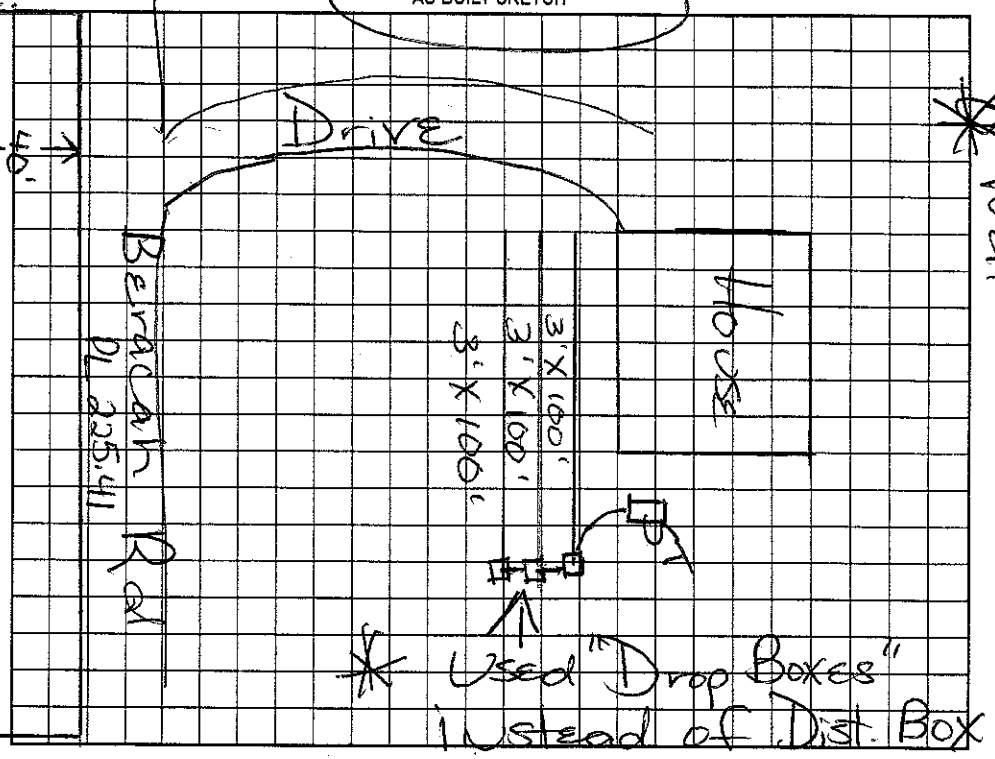

Permit can be suspended or revoked if any false information is supplied toward securing the permit/any unauthorized changes are made to the site/any unauthorized changes are made in the installation of the system. Improvement Permit with plat valid without expiration. Improvement Permit with site plan valid for sixty months. Authorization to Construct is valid for a period equal to that of Improvement Permit – not to exceed sixty months.

Signed: Paula J Bostic date 5-31-01 Installed by: Backhoe

Improvement Permit by: Maria H.H. Dotson RS date 4/11/2001 Operation Permit by: Maria H.H. Dotson RS date 7/16/2001

Authorization to Construct by: Maria H.H. Dotson R.S. date 4/11/2001 Existing System Inspection by: ____ date ____

HEALTH DEPT. COPY: WHITE OWNER COPY (FINAL): YELLOW OWNER COPY (INITIAL): PINK