IREDELL COUNTY HEALTH DEPARTMENT

STATESVILLE 704-878-5305 MOORESVILLE 704-664-5281

IMPROVEMENT PERMIT / CERTIFICATE OF COMPLETION / OPERATION PERMIT / EXISTING SYSTEM INSPECTION

PROPERTY DESCRIPTION NO. 16805 DATE 5/23/94 TAX MAP NO. Pt of 1CA23 Watershed: ☐ Yes ☑ No

OWNER OR CONTRACTOR Floyd Blackwell PHONE: Business _____ Home _____

ADDRESS PO Box 44 Connelly Springs, NC.

LOCATION SR 1297, Midway Lake Rd. TR on 1297 (just past Bayocah Place) Lrear Rt. on ①

SUBDIVISION _____ BLOCK / SECTION _____ LOT _____ LOT AREA ~9AC. SITE CLASS. P DESIGN FLOW 360 L.T.A.R. .3-.35

Septic Tank: 1500 Gallons; STB 1614 Date 4/14/94

Pump Tank: _____ Gallons; PT _____ Date _____

Pump Make: _____ Model _____ Serial No. _____

Nitrification Field: No Fields 1 Square Feet 1200 Linear Feet 400

No Lines 3 Trench Width 3' Max Trench Bottom Depth 36" Gravel Depth 12"

☑ New System ☐ Repair System Type: I, II, III, IV, V, VI

System Description: CONV. -DIST BOX

Repair System Description: _____

Maintenance Agreement Required: ☐ Yes ☑ No

☑ House/Mod. Home No. Bedrooms 3

☐ Mobile Home No. Bathrooms 2

☐ Business No. Employees ____

☑ Other 1/2 BATH + GARAGE


☐ Slab ☑ Crawl Space ☐ Basement w/plumbing ☐ Basement wo/plumbing

Water Supply: ☑ Individual ☐ Community ☐ Public


Comments: POND

Comments:

INITIAL SITE SKETCH

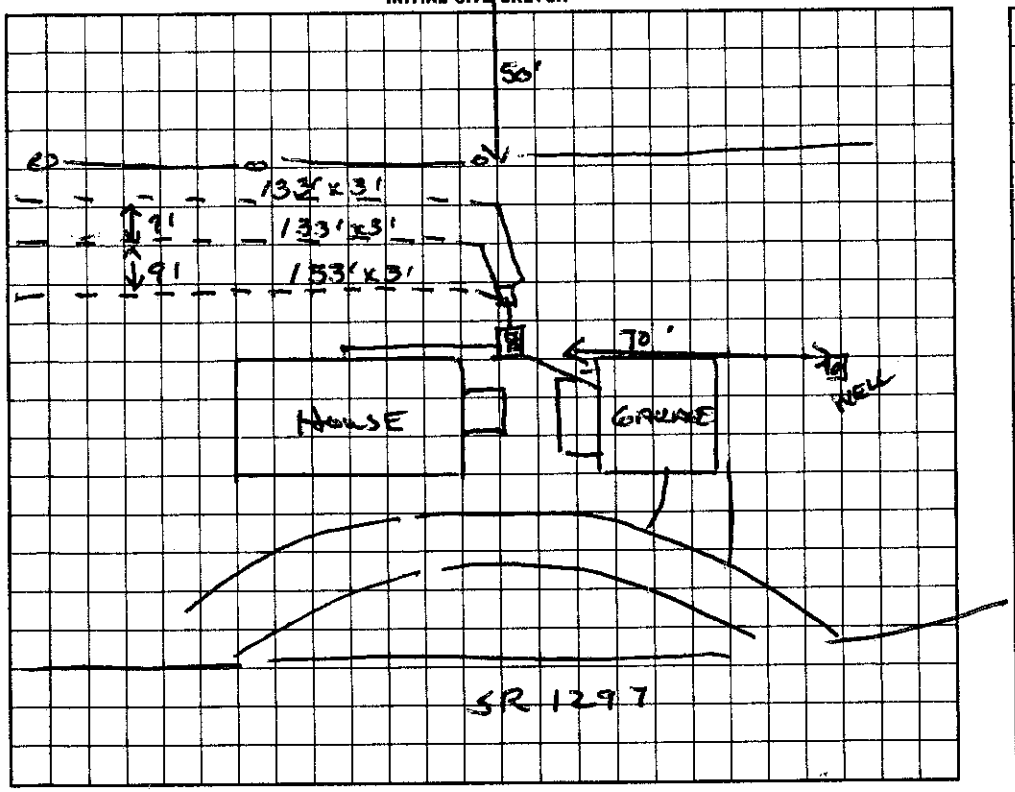

AS BUILT SKETCH

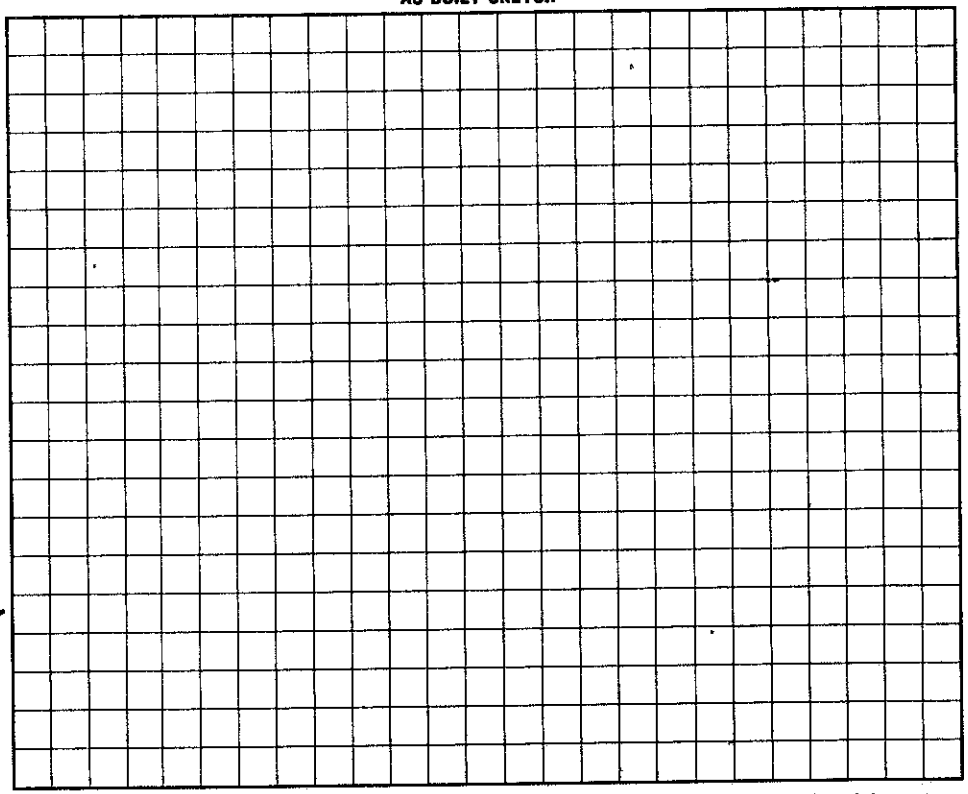

I understand that this permit can be suspended or revoked if any false information is supplied toward securing the permit/any unauthorized changes are made to the site/any unauthorized changes are made in the installation of the system. Improvement Permit is valid for 60 months from date of issuance.

Signed: ~~Wesley Sparks~~ REISSUE

Improvement Permit by: Wesley Sparks RS. date 5/23/94

Existing System Inspection by: _____ date _____

Installed by: Tim Simmons

Certificate of Completion by: Wesley Sparks RS. date 6/1/94

Operation Permit by: _____ date _____

HEALTH DEPT. COPY: WHITE INSPECTION COPY (FINAL): GREEN OWNER COPY (FINAL): YELLOW INSPECTION COPY (INITIAL): PINK OWNER COPY (INITIAL): GOLD