IREDELL COUNTY HEALTH DEPARTMENT

STATESVILLE 704-878-5305 MOORESVILLE 704-664-5281

IMPROVEMENT PERMIT / AUTHORIZATION TO CONSTRUCT / OPERATION PERMIT / EXISTING SYSTEM INSPECTION

PERMIT# Repair PIN# 4055719147 DATE 8/17/04

OWNER OR CONTRACTOR Helen Bailey PHONE: Business Home 704-596-4120

ADDRESS 7824 Twin Dr. Charlotte NC 28269

LOCATION 1155, TL Faith, TR Midway, LR, TL Tammy, on Lt #177

SUBDIVISION BLOCK / SECTION LOT LOT AREA ≈ 1 AC SITE CLASS. PS DESIGN FLOW 360 L.T.A.R. —

Septic Tank: Existing Gallons; STB Date

Pump Tank: Gallons; PT Date

Pump Make: Model Serial No.

Nitrification Field: No Fields 1 Square Feet 650 Linear Feet 65'

No Lines Trench Width 10" Max Trench Bottom Depth 36" Gravel Depth 12"

☒ New System ☒ Repair System Type: I II III IV V VI

System Description: 25% bed w/ gravel

Repair System Description: Conventional Bed

Maintenance Agreement Required: ☐ Yes ☒ No

☐ House/Mod. Home No. Bedrooms 3

☒ Mobile Home No. Bathrooms

☐ Business No. Employees

☐ Other

☐ Slab ☒ Crawl Space ☐ Basement w/plumbing ☐ Basement wo/plumbing


Water Supply: ☒ Individual ☐ Public ☐ Community

Comments:/Conditions:


Comments:/Conditions:

Existing Black Tank

INITIAL SITE SKETCH

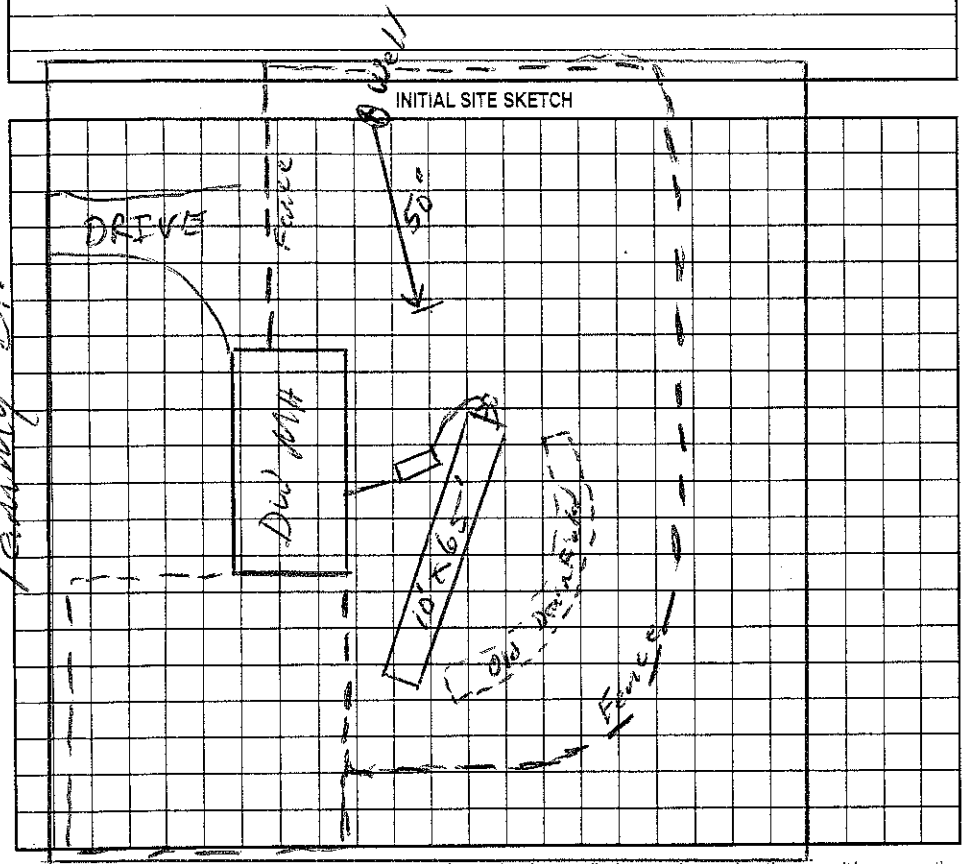

AS BUILT SKETCH

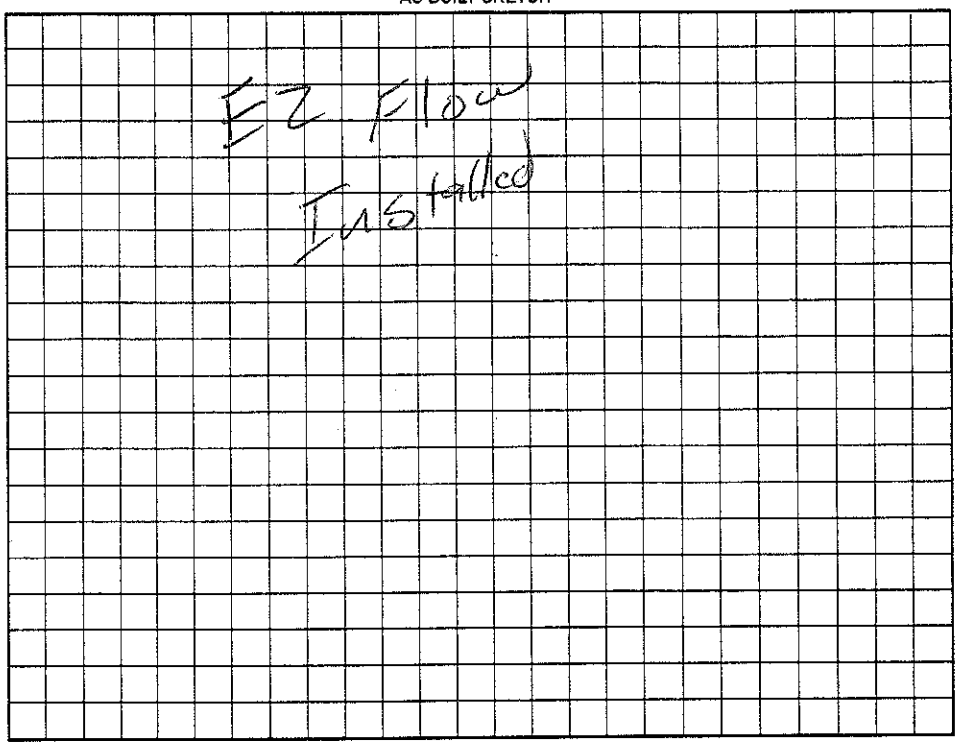

Permit can be suspended or revoked if any false information is supplied toward securing the permit/any unauthorized changes are made to the site/any unauthorized changes are made in the installation of the system. Improvement Permit with plat valid without expiration. Improvement Permit with site plan valid for sixty months. Authorization to Construct is valid for a period equal to that of Improvement Permit – not to exceed sixty months.

Signed: date

Improvement Permit by: RS date 8/17/04

Authorization to Construct by: RS date 8/17/04

Installed by: Stanley Septic

Operation Permit by: RS date 8/31/04

Existing System Inspection by: date

HEALTH DEPT. COPY: WHITE OWNER COPY (FINAL): YELLOW OWNER COPY (INITIAL): PINK