IREDELL COUNTY HEALTH DEPARTMENT

STATESVILLE 704-878-5305 2500 Paid MOORESVILLE 704-664-5281

IMPROVEMENT PERMIT / AUTHORIZATION TO CONSTRUCT / OPERATION PERMIT / EXISTING SYSTEM INSPECTION

PERMIT# 101987 PIN# 4655-77-4913.1 DATE 2/1/02

OWNER OR CONTRACTOR Mitchell Oates PHONE: Business _____ Home 704-663-2046

ADDRESS 401 Mackwood Rd. Mooresville, NC. 28115

LOCATION 1155 TL Mackwood to end house, (L) on drive

SUBDIVISION _____ BLOCK / SECTION _____ LOT _____ LOT AREA 2.0 SITE CLASS. PS DESIGN FLOW 360 L.T.A.R. .3

Septic Tank: 1000 Gallons; STB 312 Date 3/10/00
Pump Tank: _____ Gallons; PT _____ Date _____
Pump Make: _____ Model PL Serial No. _____
Nitrification Field: No Fields 1 Square Feet 1200 Linear Feet 400
No Lines 4 @ 100' Trench Width 3' Max Trench Bottom Depth 3' Gravel Depth 12"

[X] New System [ ] Repair System Type: I, (II), III, IV, V, VI
System Description: GRAV - CONVENTIONAL
Repair System Description: SAME
Maintenance Agreement Required: [ ] Yes [X] No


[X] House/Mod. Home No. Bedrooms 3
[ ] Mobile Home No. Bathrooms 2
[ ] Business No. Employees ____
[ ] Other _____

[ ] Slab [X] Crawl Space [ ] Basement w/plumbing [ ] Basement wo/plumbing

Water Supply: [X] Individual [ ] Public [ ] Community

Comments:/Conditions:

INITIAL SITE SKETCH

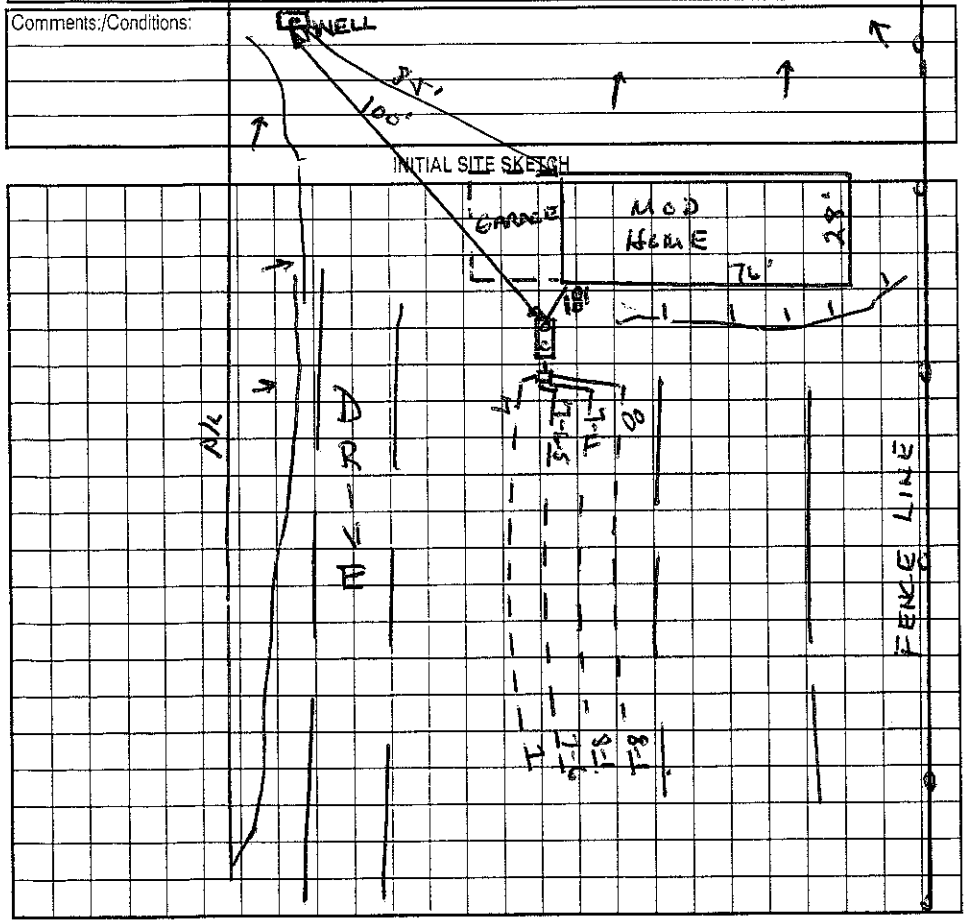

Comments:/Conditions:

AS BUILT SKETCH

Permit can be suspended or revoked if any false information is supplied toward securing the permit/any unauthorized changes are made to the site/any unauthorized changes are made in the installation of the system. Improvement Permit with plat valid without expiration. Improvement Permit with site plan valid for sixty months. Authorization to Construct is valid for a period equal to that of Improvement Permit – not to exceed sixty months.

Signed: *Jennifer Oates date 2-21-02 Installed by: FJ Ervin

Improvement Permit by: Wesley Sparks RS. date 2/1/02 Operation Permit by: Wesley Sparks RS. date 4/26/02

Authorization to Construct by: Wesley Sparks RS. date 2/1/02 Existing System Inspection by: _____ date _____

HEALTH DEPT. COPY: WHITE OWNER COPY (FINAL): YELLOW OWNER COPY (INITIAL): PINK