# IREDELL COUNTY HEALTH DEPARTMENT

STATESVILLE 704-878-5305 MOORESVILLE 704-664-5281

PIN# 4655-80-1149

## IMPROVEMENT PERMIT / CERTIFICATE OF COMPLETION / OPERATION PERMIT / EXISTING SYSTEM INSPECTION

PROPERTY DESCRIPTION NO. 18911 DATE 8/18/94 TAX MAP NO. 1C-9-A-18A of Watershed: ☐ Yes ☑ No

OWNER OR CONTRACTOR John [redacted] DULIN PHONE: Business _____ Home _____

ADDRESS 18910 Davidson-Concord Rd. Davidson, NC. 28036

LOCATION Beraeah Place on (L)

SUBDIVISION Beraeah Pl. BLOCK / SECTION _____ LOT Rev 18-3 LOT AREA ~.95AC SITE CLASS. P DESIGN FLOW 360 (486 Beds) L.T.A.R. .3

Septic Tank: 1000 Gallons; STB 794 Date 7/13/96

Pump Tank: _____ Gallons; PT _____ Date _____

Pump Make: _____ Model 1660 Serial No. 533 Acres

Nitrification Field: No Fields 1 Square Feet ~~1200~~ Linear Feet ~~400~~

No Lines 3 (4 Beds) Trench Width 36" Max Trench Bottom Depth 32" Gravel Depth 12"

☑ New System ☐ Repair System Type: I, (II) III, IV, V, VI

System Description: CONV - DIST BOX

Repair System Description: _____

Maintenance Agreement Required: ☐ Yes ☐ No

☑ House/Mod. Home No. Bedrooms 3

☐ Mobile Home No. Bathrooms 2

☐ Business No. Employees _____

☐ Other _____

☐ Slab ☑ Crawl Space ☐ Basement w/plumbing ☐ Basement wo/plumbing

Water Supply: ☑ Individual ☐ Community ☐ Public


Comments:

Trench bottom 30-32"
Line on slope contour.
Flow Divider - 2 Dist Boxes
WELL

Comments:

Installed as shown

INITIAL SITE SKETCH

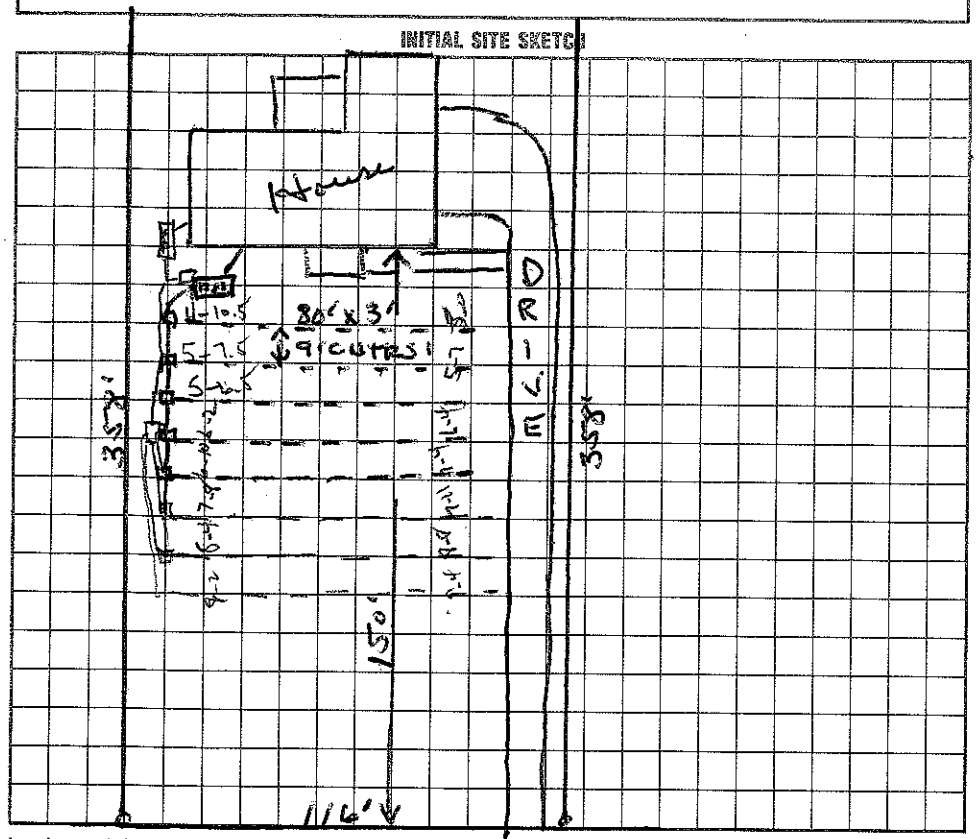


AS BUILT SKETCH

I understand that this permit can be suspended or revoked if any false information is supplied toward securing the permit/any unauthorized changes are made to the site/any unauthorized changes are made in the installation of the system. Improvement Permit is valid for 60 months from date of issuance.

Signed: John B Dulin BEACHAM DR.

Improvement Permit by: Wendy Sparks RS. date 8/18/94

Existing System Inspection by: _____ date _____

Installed by: Ray Beam

Certificate of Completion by: _____ date _____

Operation Permit by: Wendy Sparks RS. date 9/23/96

HEALTH DEPT. COPY: WHITE INSPECTION COPY (FINAL): GREEN OWNER COPY (FINAL): YELLOW INSPECTION COPY (INITIAL): PINK OWNER COPY (INITIAL): GOLD