IREDELL COUNTY HEALTH DEPARTMENT

PIN# 4655-80-2167

STATESVILLE 704-878-5305 MOORESVILLE 704-664-5281

IMPROVEMENT PERMIT / CERTIFICATE OF COMPLETION / OPERATION PERMIT / EXISTING SYSTEM INSPECT.

PROPERTY DESCRIPTION NO. 23052 DATE 1-27-96 TAX MAP NO. 1C-9-A-17 Watershed: ☐ Yes ☒ No

OWNER OR CONTRACTOR DAVID RUSHING PHONE: Business Home 399-6722

ADDRESS 2419 OLDE WHITEHALL RD CHARLOTTE, NC 28273

LOCATION NC 115 S, TL MIDWAY LAKE ROAD, TR BERACAH LANE, 2ND LOT FROM END ON LEFT

SUBDIVISION BERACAH PLACE BLOCK / SECTION LOT 17 LOT AREA 1.000 AC SITE CLASS. PS DESIGN FLOW 360 L.T.A.R. 0.40 GPD/FT²

Septic Tank: 1500 Gallons; STB 799 Date 6/23/96

Pump Tank: Gallons; PT Date

Pump Make: Model Serial No.

Nitrification Field: No Fields 1 Square Feet 900 Linear Feet 300

No Lines 4 Trench Width 36" Max Trench Bottom Depth 18-36" Gravel Depth 12"

☑ New System ☐ Repair System Type: I (II) III, IV, V, VI

System Description: CONVENTIONAL GRAVITY

Repair System Description: CONVENTIONAL PUMP

Maintenance Agreement Required: ☐ Yes ☑ No

☑ House/Mod. Home No. Bedrooms 3

☐ Mobile Home No. Bathrooms 2½

☐ Business No. Employees

☐ Other


☐ Slab ☑ Crawl Space ☐ Basement w/plumbing ☐ Basement wo/plumbing

Water Supply: ☑ Individual ☐ Community ☐ Public WELL


Comments: (1) KEEP SYSTEM MINIMUM 100' FROM WELL, 10' FROM PROPERTY LINE, 5' FROM FOUNDATION (2) INSTALL LINES ON CONTOUR (3) USE THREE FLOW DIVIDER TEES TO ACHIEVE EQUAL DISTRIBUTION INTO EACH OF FOUR 75' LINES

Comments:

INITIAL SITE SKETCH

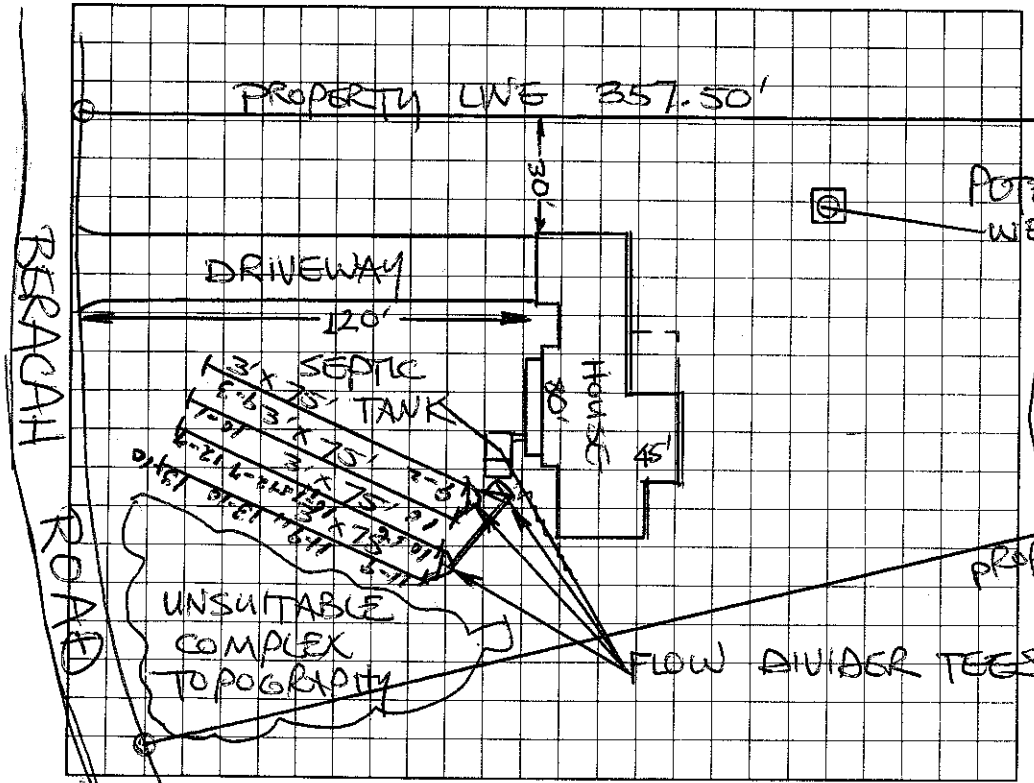

AS BUILT SKETCH

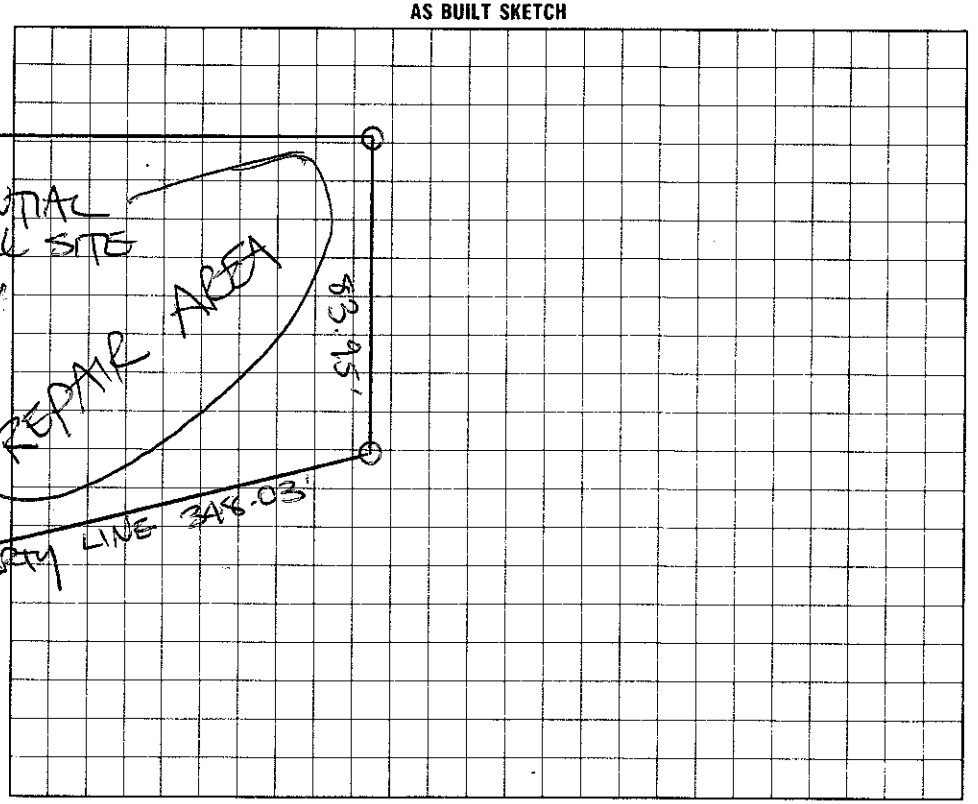

I understand that this permit can be suspended or revoked if any false information is supplied toward securing the permit/any unauthorized changes are made to the site/any unauthorized changes are made in the installation of the system.

AUTHORIZATION TO CONSTRUCT IS VALID FIVE (5) YEARS FROM DATE OF ISSUANCE. IMPROVEMENT PERMIT HAS NO EXPIRATION DATE.

Signed X David Rushing

Improvement Permit by: STEVE HEDRICK date 1-27-96

AUTHORIZATION TO CONSTRUCT

Existing System Inspection by: STEVE HEDRICK date 1-27-96

Installed by: F J Ervin

Certificate of Completion by: date

Operation Permit by: Wesley Sparks RS. date 3/9/96

HEALTH DEPT. COPY: WHITE INSPECTION COPY (FINAL): GREEN OWNER COPY (FINAL): YELLOW INSPECTION COPY (INITIAL): PINK OWNER COPY (INITIAL): GOLD