IREDELL COUNTY HEALTH DEPARTMENT

Authorization to construct 4655847713 4-30

STATESVILLE 704-878-5305 MOORESVILLE 704-664-5281

IMPROVEMENT PERMIT / ~~CERTIFICATE OF COMPLETION~~ / OPERATION PERMIT / EXISTING SYSTEM INSPECTION

PROPERTY DESCRIPTION NO. 26231 DATE 3/20/97 TAX MAP NO. 4655-84-7713 Watershed: ☐ Yes ☒ No

OWNER OR CONTRACTOR PHILLIP MOORE PHONE: Business _____ Home 663-0513

ADDRESS 547 FAITH RD MOORESVILLE NC 28115

LOCATION 115 S - TL FAITH RD - 2.2 MILES ON LEFT - # 547 FAITH RD

SUBDIVISION _____ BLOCK / SECTION _____ LOT _____ LOT AREA 1 AC SITE CLASS. B DESIGN FLOW 360 GPD L.T.A.R. —

Septic Tank: 1000 EXISTING Gallons; STB _____ Date _____

Pump Tank: _____ Gallons; PT _____ Date _____

Pump Make: _____ Model _____ Serial No. _____

Nitrification Field: No Fields 1 Square Feet 480 Linear Feet 160

No Lines 4 @ 40' Trench Width 36" Max Trench Bottom Depth 36" Gravel Depth 12"

☒ New System ☐ Repair System Type: I, II, III, IV, V, VI

System Description: GRAVITY CONVENTIONAL

Repair System Description: PANEL

Maintenance Agreement Required: ☐ Yes ☒ No

☒ House/Mod. Home No. Bedrooms 3

☐ Mobile Home No. Bathrooms 2

☐ Business No. Employees ____

☐ Other _____


☐ Slab ☒ Crawl Space ☐ Basement w/plumbing ☐ Basement wo/plumbing

Water Supply: ☒ Individual ☐ Community ☐ Public


Comments: KEEP 5' FROM EXISTING SYSEM AND NEW SEPTIC SYSTEM.

Comments:

INITIAL SITE SKETCH

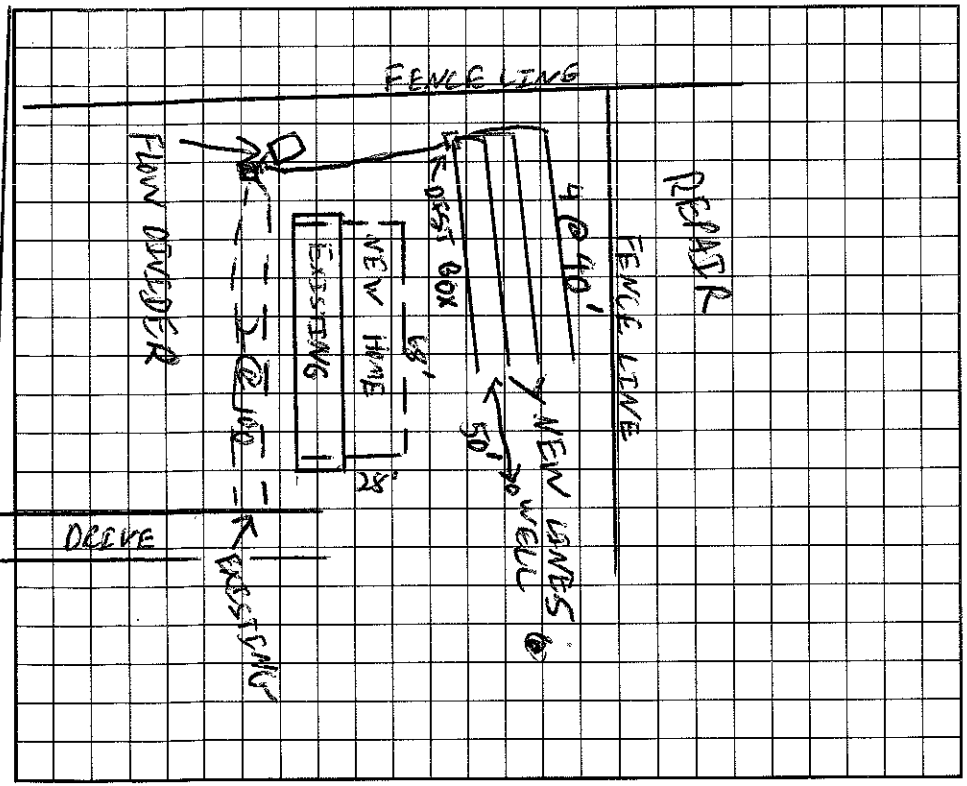

AS BUILT SKETCH

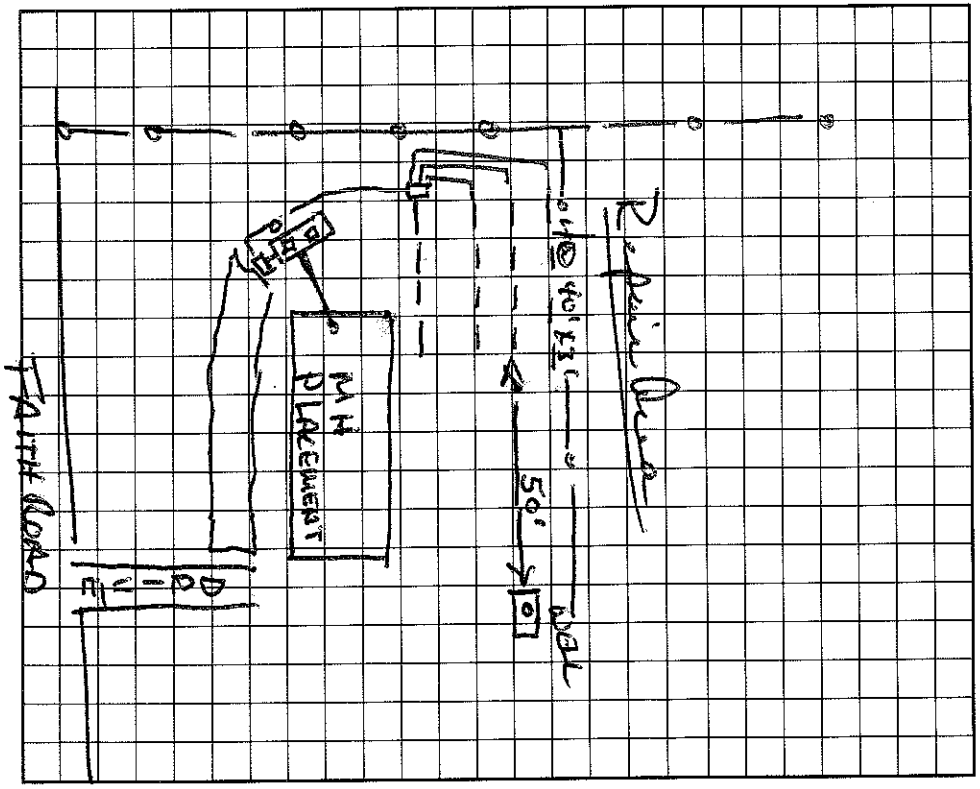

I understand that this permit can be suspended or revoked if any false information is supplied toward securing the permit/any unauthorized changes are made to the site/any unauthorized changes are made in the installation of the system. Improvement Permit is valid for 60 months from date of issuance.

Signed: Phillip Moore

Improvement Permit by: C. Ray Freeman EHSP date 3/20/97

Authorization to Construct Existing System Inspection by: C. Ray Freeman EHSP date 3/20/97

OLD PERMIT

Installed by: JULIAN BOWLES/1986 NEW →

Certificate of Completion by: Wesley Spencer R.S. date 6/5/97

Operation Permit by: Wesley Spencer R.S. date 6/5/97

HEALTH DEPT. COPY: WHITE INSPECTION COPY (FINAL): GREEN OWNER COPY (FINAL): YELLOW INSPECTION COPY (INITIAL): PINK OWNER COPY (INITIAL): GOLD