IREDELL COUNTY HEALTH DEPARTMENT

STATESVILLE 704-878-5305 130.00 ta.9 3130 MOORESVILLE 704-664-5281

IMPROVEMENT PERMIT / AUTHORIZATION TO CONSTRUCT / OPERATION PERMIT / EXISTING SYSTEM INSPECTION

PERMIT# 112 119 PIN# ~~4655-84-8495~~ 4655849444 DATE

OWNER OR CONTRACTOR Gracie Redfear PHONE: Business Home 704-663-3685

ADDRESS 544 Faith Rd. Mooresville NC 28115

LOCATION 1155, TL Faith, 3rd Drive on RT Past Creek

SUBDIVISION BLOCK / SECTION LOT LOT AREA 0.777 AC SITE CLASS. PS DESIGN FLOW 360 L.T.A.R. 0.3

Septic Tank: 1000 Gallons; STB 312 Date 3/3/03
Pump Tank: Gallons; PT Date
Pump Make: Model Serial No.
Nitrification Field: No Fields 1 Square Feet 900 Linear Feet 300
No Lines 3@100' Trench Width 36" Max Trench Bottom Depth ~~24~~ 24" Gravel Depth —

☒ New System ☐ Repair System Type: I, II, III, IV, V, VI
System Description: Gravity 25% Reduction
Repair System Description: Payne/Black
Maintenance Agreement Required: ☐ Yes ☒ No

☒ House/Mod. Home No. Bedrooms 3
☐ Mobile Home No. Bathrooms 1½
☐ Business No. Employees
☐ Other


☐ Slab ☒ Crawl Space ☐ Basement w/plumbing ☐ Basement wo/plumbing

Water Supply: ☒ Individual ☐ Public ☐ Community


Comments:/Conditions:

Comments:/Conditions:

INITIAL SITE SKETCH

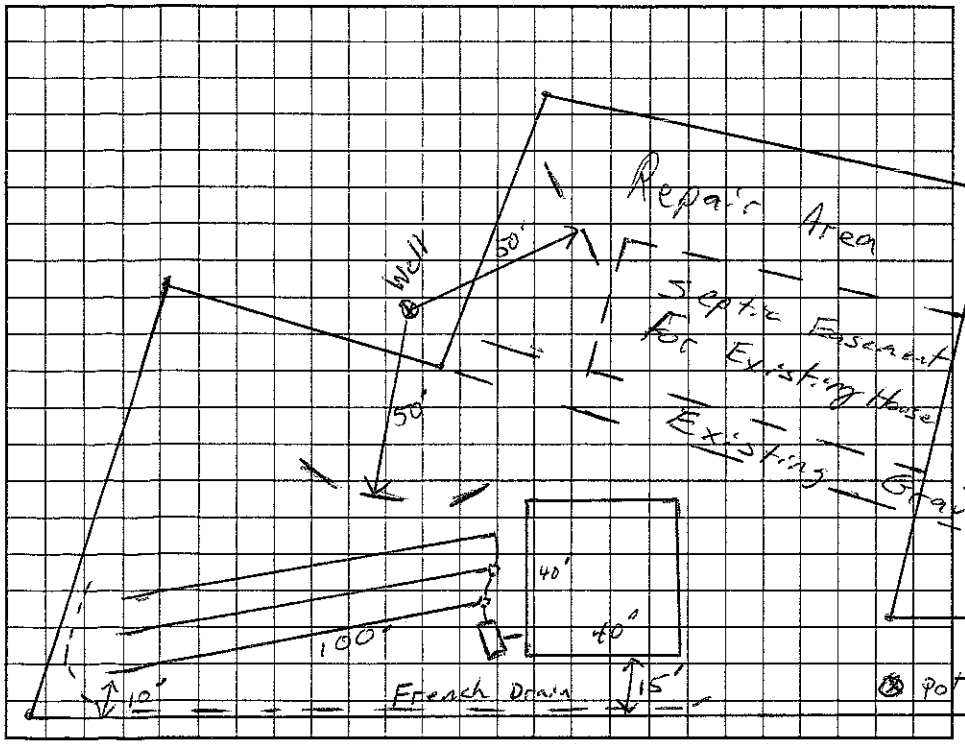

AS BUILT SKETCH

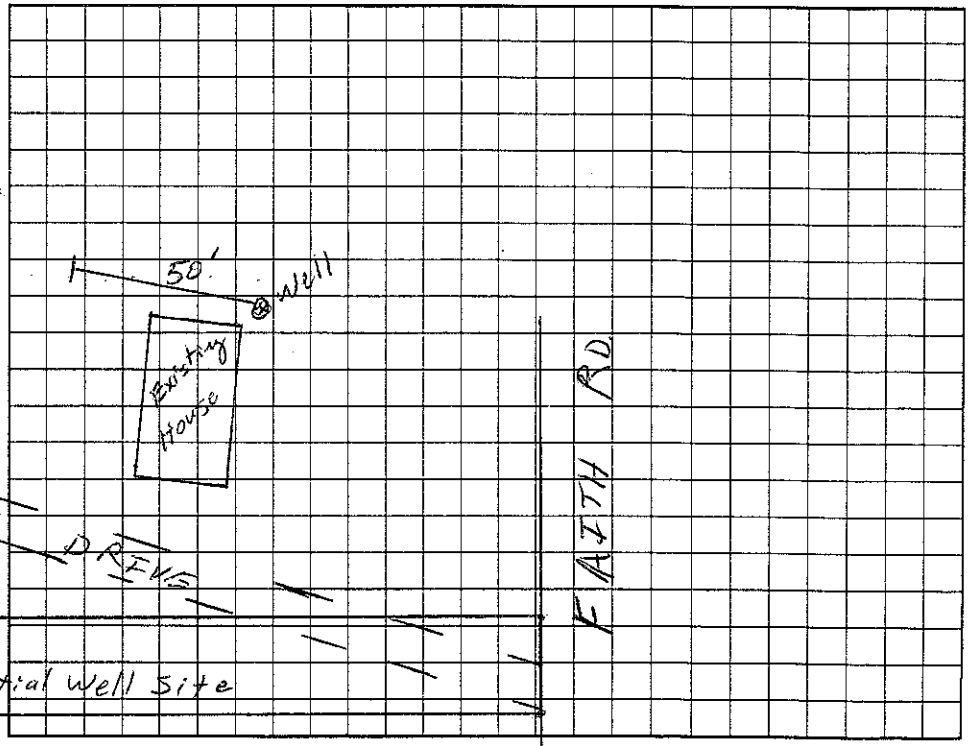

Permit can be suspended or revoked if any false information is supplied toward securing the permit/any unauthorized changes are made to the site/any unauthorized changes are made in the installation of the system. Improvement Permit with plat valid without expiration. Improvement Permit with site plan valid for sixty months. Authorization to Construct is valid for a period equal to that of Improvement Permit – not to exceed sixty months.

Signed: Herbert Redfear date 5-7-03 Installed by: A. Cornelius Gosdin

Improvement Permit by: RS date 5/21/03 Operation Permit by: RS date 11/4/03

Authorization to Construct by: RS date 5/21/03 Existing System Inspection by: date

HEALTH DEPT. COPY: WHITE OWNER COPY (FINAL): YELLOW OWNER COPY (INITIAL): PINK