IREDELL COUNTY HEALTH DEPARTMENT

Author to Construct 4655942944 10:30

STATESVILLE 704-878-5305 MOORESVILLE 704-664-5281

IMPROVEMENT PERMIT / ~~CERTIFICATE OF COMPLETION~~ / OPERATION PERMIT / EXISTING SYSTEM INSPECTION

PROPERTY DESCRIPTION NO. 067488 DATE 6/14/97 TAX MAP NO. 4655941829 Watershed: ☐ Yes ☒ No

OWNER OR CONTRACTOR Richard Dangelo (Laura Dangelo) PHONE: Business _____ Home 663-2842

ADDRESS 583 Faith Rd. Mooresville, NC. 28115

LOCATION 1155 TL Faith Rd. X Gridge on (L) before #583 Faith Rd.

SUBDIVISION N/A BLOCK / SECTION _____ LOT _____ LOT AREA 20000 FT² SITE CLASS. PS DESIGN FLOW 360 L.T.A.R. .3

Septic Tank: 1000 Gallons; STB 825 Date 5/15/97

Pump Tank: _____ Gallons; PT _____ Date _____

Pump Make: _____ Model _____ Serial No. _____

Nitrification Field: No Fields 1 Square Feet 1200 Linear Feet 460

No Lines 5 Trench Width 36" Max Trench Bottom Depth 28" Gravel Depth 12"

☒ New System ☐ Repair System Type: I, II, III, IV, V, VI

System Description: Gravity Conventional Trench

Repair System Description: _____

Maintenance Agreement Required: ☐ Yes ☒ No

☐ House/Mod. Home ☒ Mobile Home ☐ Business ☐ Other

No. Bedrooms 3 No. Bathrooms 1 No. Employees _____


☐ Slab ☒ Crawl Space ☐ Basement w/plumbing ☐ Basement wo/plumbing

Water Supply: ☒ Individual ☐ Community ☐ Public FATHERS


Comments:

Comments:

INITIAL SITE SKETCH

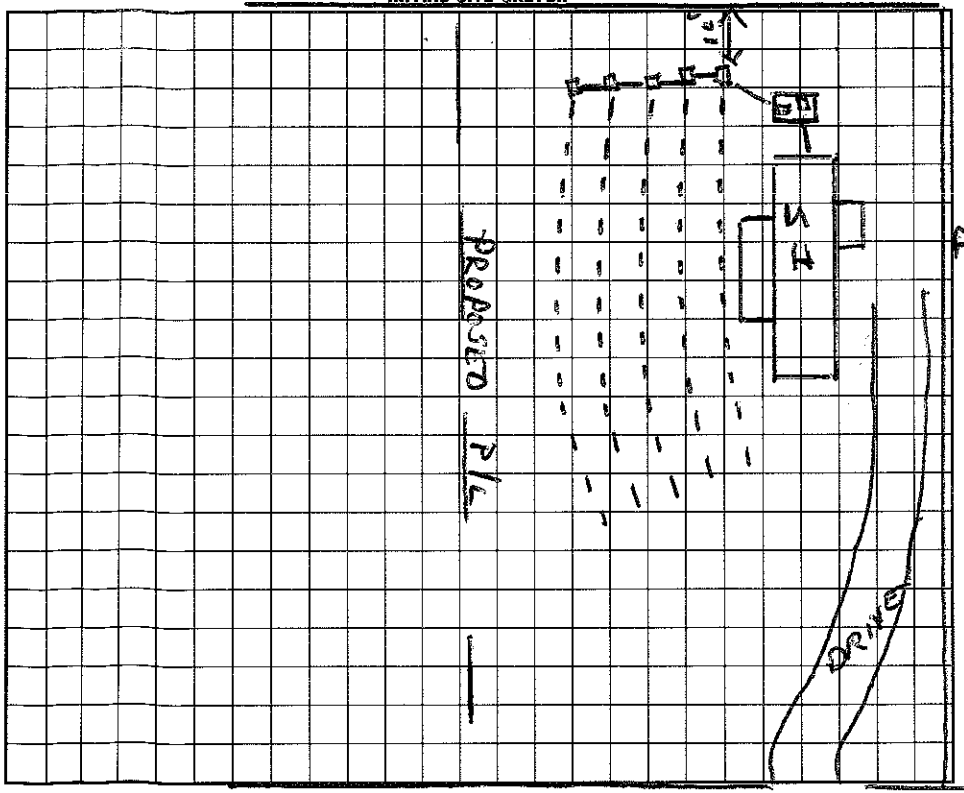

AS BUILT SKETCH

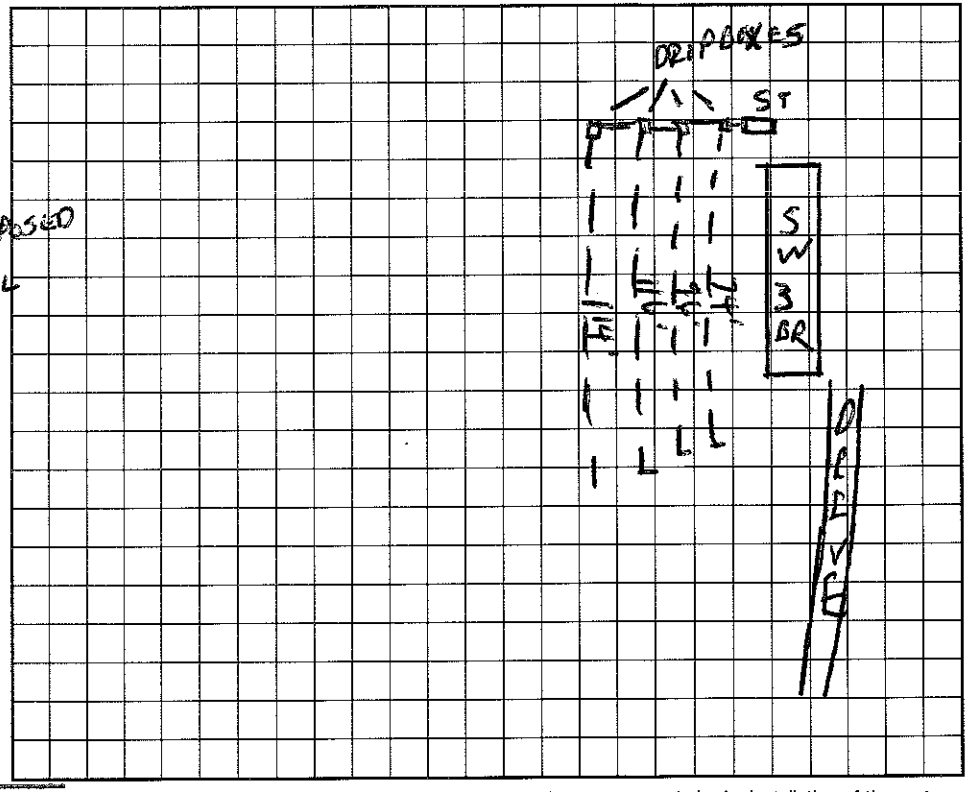

I understand that this permit can be suspended or revoked if any false information is supplied toward securing the permit/any unauthorized changes are made to the site/any unauthorized changes are made in the installation of the system. Improvement Permit is valid for 60 months from date of issuance.

FAITH RD.

Signed: Laura Dangelo

Improvement Permit by: Wesley Sparks R.S. date 6/16/97

~~Authorized~~ Existing System Inspection by: Wesley Sparks R.S. date 6/16/97

Installed by: BOSTIAN

Certificate of Completion by: _____ date _____

Operation Permit by: C. Brady Toomey date 7/10/97

HEALTH DEPT. COPY: WHITE INSPECTION COPY (FINAL): GREEN OWNER COPY (FINAL): YELLOW INSPECTION COPY (INITIAL): PINK OWNER COPY (INITIAL): GOLD