IREDELL COUNTY HEALTH DEPARTMENT

STATESVILLE 704-878-5305 MOORESVILLE 704-664-5281

IMPROVEMENT PERMIT / AUTHORIZATION TO CONSTRUCT / OPERATION PERMIT / EXISTING SYSTEM INSPECTION

PERMIT# 140470 PIN# 4655944659 4655-94-5544 DATE 3-5-07

OWNER OR APPLICANT James Danyels PHONE: Business 704-507-4207 Home 704-799-9006

ADDRESS 573 Faith Rd 28115

LOCATION Hwy 115 S Tl Faith 3 mi on right just past Charity Ln

SUBDIVISION Danyels Place BLOCK / SECTION ____ LOT 3 LOT AREA 1.2 Ac SITE CLASS. PS DESIGN FLOW 360 gpd L.T.A.R. .2 gpd/ft²

Septic Tank: 1000 Gallons: STB 794 Date 6-1-07
Pump Tank: ____ Gallons: PT ____ Date ____
Pump Make: ____ Model ____ Serial No. ____
Nitrification Field: No Fields 1 Square Feet 1800 Linear Feet 450
No Lines 6@75' Trench Width 36" Max Trench Bottom Depth 36" Gravel Depth NA

☒ New System ☐ Repair ☐ Expansion System Type: I II III IV V VI
System Description: 25% reduction gravity
Repair System Description: 25% reduction pump
Maintenance Agreement Required: ☐ Yes ☒ No

☒ House/Mod. Home No. Bedrooms 3
☐ Mobile Home No. Persons 6
☐ Business No. Employees ____
☐ Other ____


Water Supply: ☒ Individual ☐ Public ☐ Community

☐ Slab ☒ Crawl Space ☐ Basement w/plumbing ☐ Basement wo/plumbing


Comments:/Conditions: Install at 36" trench bottom
House moved 20' back to 89' off front property line

Comments:/Conditions:
Red Poly lok filter
ST w/ marker

1"=50' INITIAL SITE SKETCH

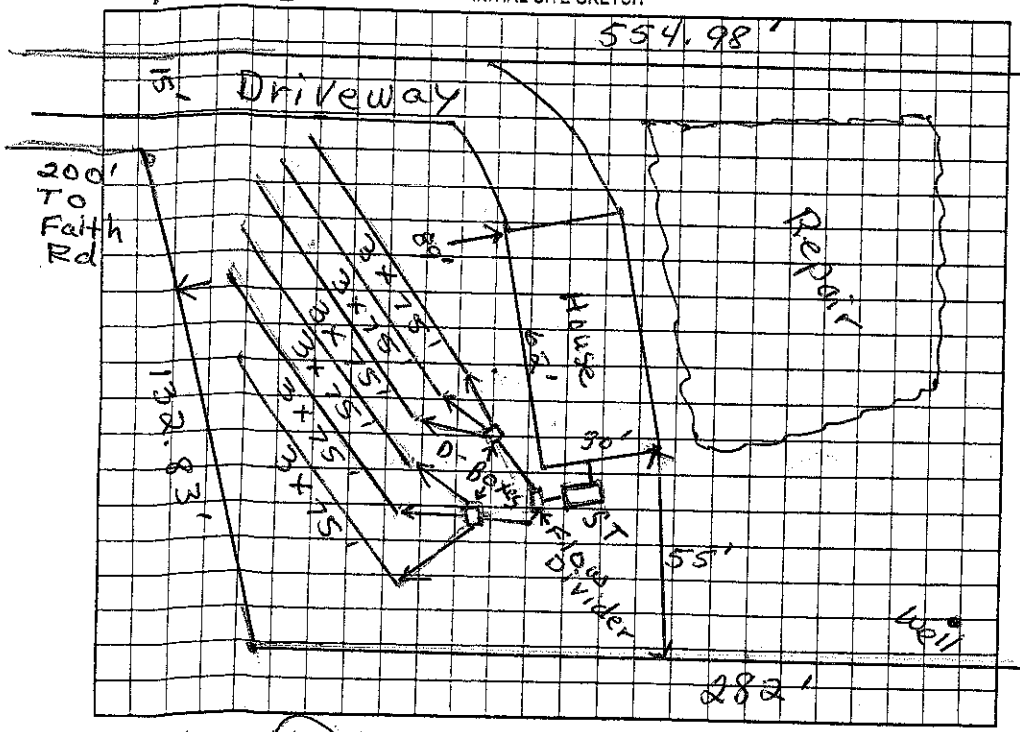

AS BUILT SKETCH

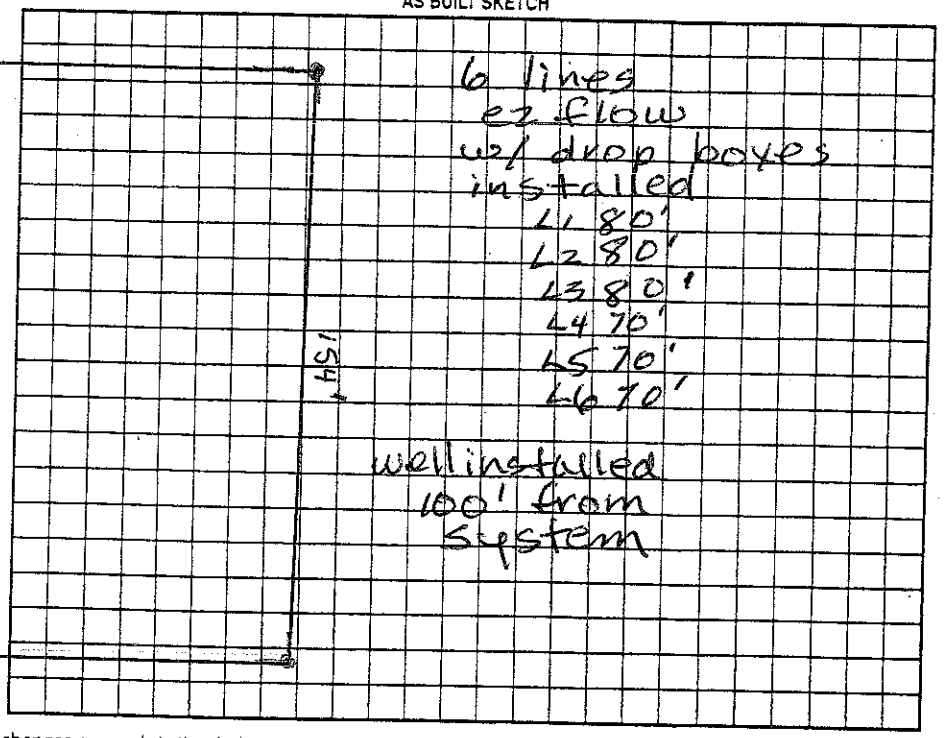

Permit can be suspended or revoked if any false information is supplied toward securing the permit/any unauthorized changes are made to the site/any unauthorized changes are made in the installation of the system. Improvement Permit with plat valid without expiration ☐ Improvement Permit with site plan valid for sixty months ☒ Authorization to Construct is valid for a period equal to that of Improvement Permit – not to exceed sixty months.

Signed: James Danyels date 3-5-07
Improvement Permit by: Judy Melville date 3-5-07
Authorization to Construct by: Judy Melville date 3-5-07

Installed by: H & H Landscaping & Grading Stevens Trucking & Septic
Operation Permit by: Judy Melville date 6-14-07
Existing System Inspection by: ____ date ____

HEALTH DEPT. COPY: WHITE OWNER COPY (FINAL): YELLOW OWNER COPY (INITIAL): PINK