IREDELL COUNTY HEALTH DEPARTMENT

STATESVILLE 704-878-5305 MOORESVILLE 704-664-5281

IMPROVEMENT PERMIT / AUTHORIZATION TO CONSTRUCT / OPERATION PERMIT / EXISTING SYSTEM INSPECTION

PERMIT# 101641 PIN# 4656 00 1689 4656 00 3861 DATE 10/2/2001

OWNER OR CONTRACTOR Theresa Sloan PHONE: Business Home

ADDRESS

LOCATION 115 S. TR Leslie Lp TR Crossrail Rd to drive on left - 151 Crossrail

SUBDIVISION BLOCK / SECTION LOT LOT AREA .6 Acre SITE CLASS. PS DESIGN FLOW 240 L.T.A.R. .3 -.325

Septic Tank: 1000 Gallons; STB 794 Date 11-28-00
Pump Tank: Gallons; PT Date
Pump Make: Model Serial No.
Nitrification Field: No Fields 1 Square Feet 750+ Linear Feet 250+
No Lines 5@50' Trench Width 36" Max Trench Bottom Depth 36" Gravel Depth 12"

☒ New System ☐ Repair System Type: I, II, III, IV, V, VI
System Description: Gravity Conventional
Repair System Description: Pump/Grav. Innovative
Maintenance Agreement Required: ☐ Yes ☒ No


☒ House/Mod. Home No. Bedrooms 2
☐ Mobile Home No. Bathrooms 1.5
☐ Business No. Employees
☐ Other
☐ Slab ☐ Crawl Space ☐ Basement w/plumbing ☐ Basement wo/plumbing

Water Supply: ☒ Individual Share ☐ Public ☐ Community


Comments:/Conditions: To Crossrail

Comments:/Conditions: Speed levelers installed

INITIAL SITE SKETCH

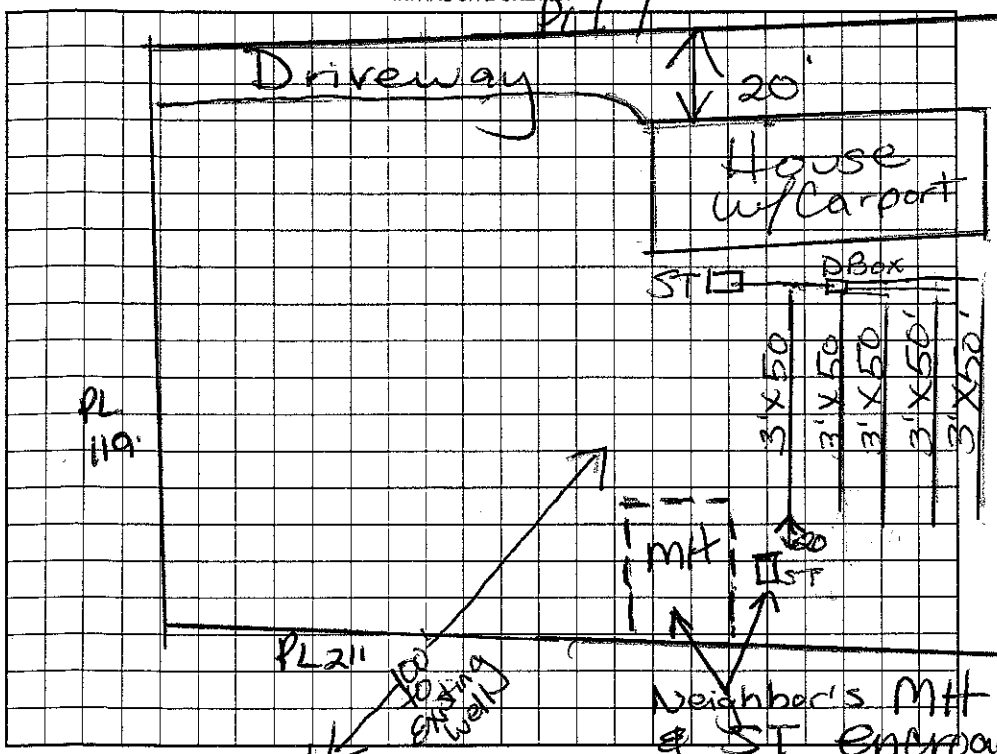

AS BUILT SKETCH

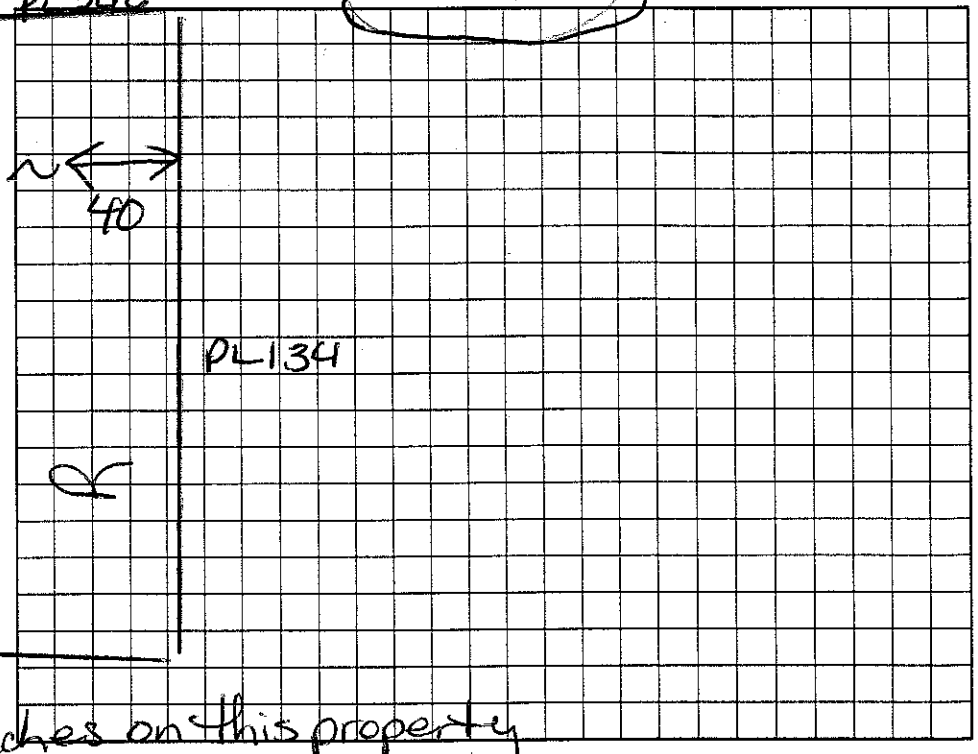

Permit can be suspended or revoked if any false information is supplied toward securing the permit/any unauthorized changes are made to the site/any unauthorized changes are made in the installation of the system. Improvement Permit with plat valid without expiration. Improvement Permit with site plan valid for sixty months. Authorization to Construct is valid for a period equal to that of Improvement Permit – not to exceed sixty months.

Signed: date

Improvement Permit by: date

Authorization to Construct by: date

Installed by: FJ Ervin

Operation Permit by: RS. date 10/2/2001

Existing System Inspection by: date

HEALTH DEPT. COPY: WHITE OWNER COPY (FINAL): YELLOW OWNER COPY (INITIAL): PINK