IREDELL COUNTY HEALTH DEPARTMENT

STATESVILLE 704-878-5305 MOORESVILLE 704-664-5281

11:30

IMPROVEMENT PERMIT / AUTHORIZATION TO CONSTRUCT / OPERATION PERMIT / EXISTING SYSTEM INSPECTION

PERMIT# 1491 PIN# 4656 00 1687

OWNER OR CONTRACTOR Theresa Sloan DATE 7/10/01

ADDRESS 618 Chal Dr. Statesville, NC. 28677 PHONE: Business _____ Home 704-838-0652

LOCATION 115 S TR Leslie Lp. TR Cromail Rd. to drive on (L)

SUBDIVISION No BLOCK / SECTION _____ LOT _____ LOT AREA ± 6 AC SITE CLASS. P5 DESIGN FLOW 240 L.T.A.R. .3

Septic Tank: 1000 Gallons; STB _____ Date _____

Pump Tank: _____ Gallons; PT _____ Date _____

Pump Make: _____ Model _____ Serial No. 250

Nitrification Field: No Fields 1 Square Feet 800 Linear Feet 240

No Lines 4 @ 60' Trench Width 3' Max Trench Bottom Depth 3'

☒ New System ☐ Repair System Type: I (II) III, IV, V, VI

System Description: GRAV - CONVENTIONAL

Repair System Description: SAME

Maintenance Agreement Required: ☐ Yes ☒ No

Gravel Depth 12"

☒ House/Mod. Home No. Bedrooms 2

☐ Mobile Home No. Bathrooms 1.5

☐ Business No. Employees _____

☐ Other _____

☐ Slab ☒ Crawl Space ☐ Basement w/plumbing ☐ Basement wo/plumbing


Water Supply: ☒ Individual ☐ Public ☐ Community NEIGHBORS

Comments:/Conditions: 50 @ 50


Comments:/Conditions:

(1" = 40')

INITIAL SITE SKETCH

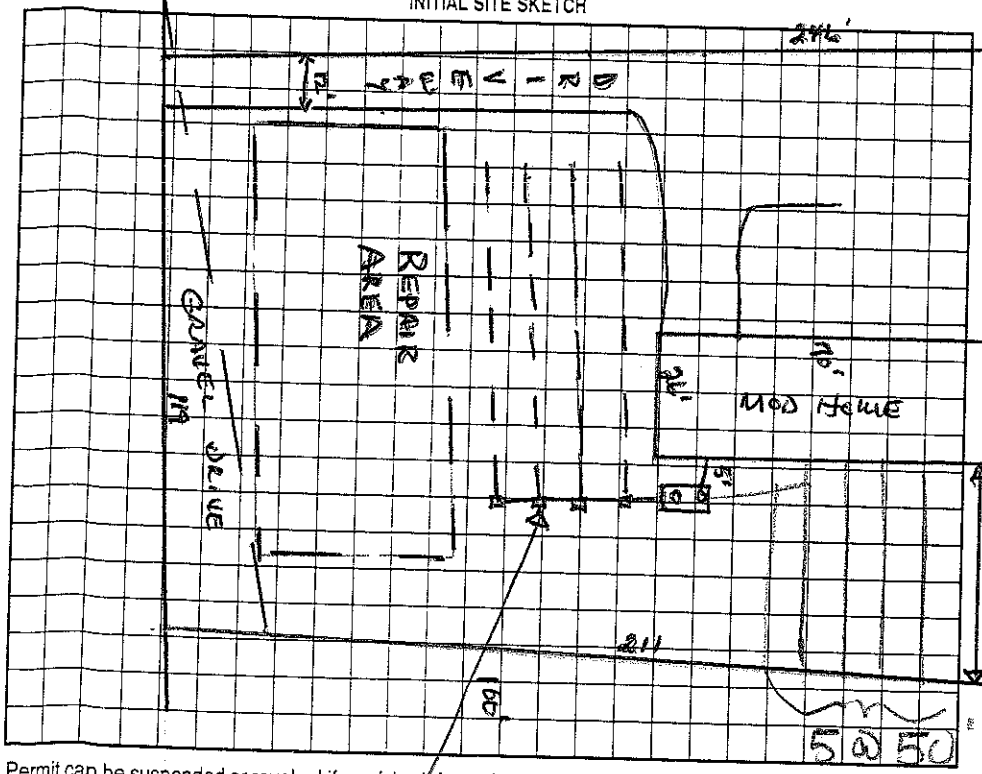

AS BUILT SKETCH

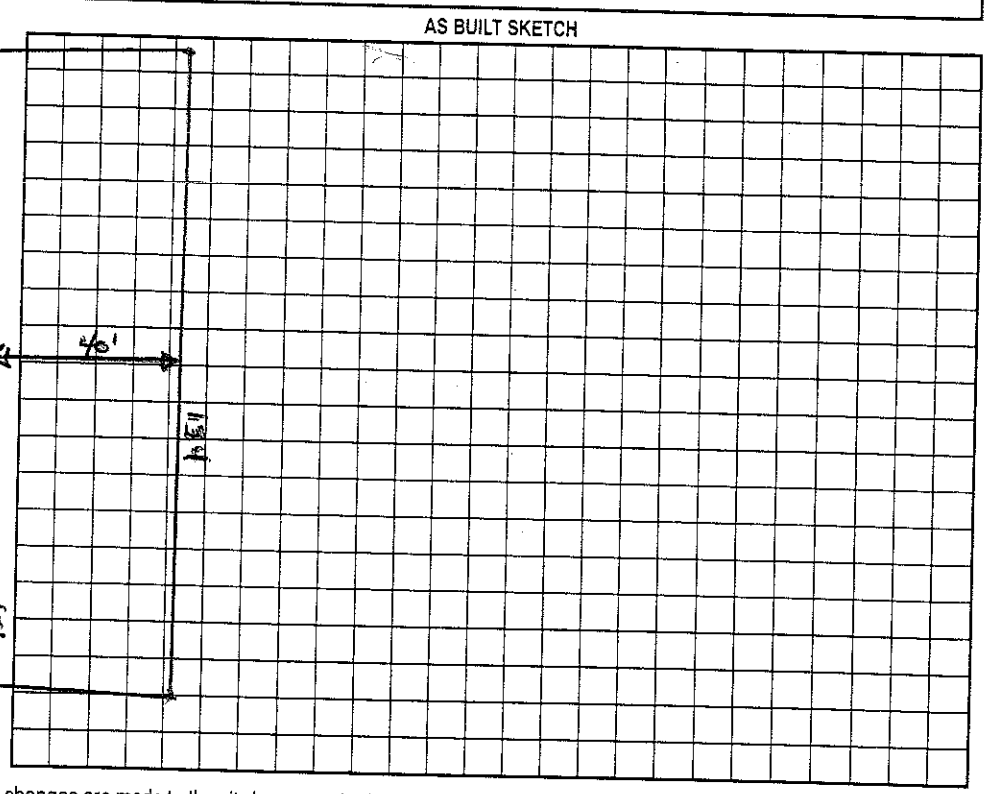

Permit can be suspended or revoked if any false information is supplied toward securing the permit/any unauthorized changes are made to the site/any unauthorized changes are made in the installation of the system. Improvement Permit with plat valid without expiration/ Improvement Permit with site plan valid for sixty months. Authorization to Construct is valid for a period equal to that of Improvement Permit – not to exceed sixty months.

Signed: ✱Theresa Sloan date 7/10/01 Installed by: _____

Improvement Permit by: Wesley Sparks RS. date 7/10/01 Operation Permit by: _____ date _____

Authorization to Construct by: Wesley Sparks RS. date 7/10/01 Existing System Inspection by: _____ date _____

HEALTH DEPT. COPY: WHITE OWNER COPY (FINAL): YELLOW