IREDELL COUNTY HEALTH DEPARTMENT

STATESVILLE 704-878-5305 4656016054 MOORESVILLE 704-664-5281

IMPROVEMENT PERMIT / CERTIFICATE OF COMPLETION / OPERATION PERMIT / EXISTING SYSTEM INSPECTION

PROPERTY DESCRIPTION NO. 1707 | DATE Sept. 27, '93 | TAX MAP NO. 5H4A4

OWNER OR CONTRACTOR Robert F. Jordan | PHONE: Business | Home

ADDRESS Rt 11, Box 330 Mooresville NC

LOCATION I-75 S. TR Mt Mourne Loop TR Cross Rail Rd. 500'-1000' on Right

SUBDIVISION | BLOCK / SECTION | LOT | LOT AREA 1 ACRES | SITE CLASS. PS | L.T.A.R. .03

Water Supply: ☑ Individual ☐ Community ☐ Public

Septic Tank: 1000 Gallons; STB 825 RST Date 8-13-93

Pump Tank: Gallons; PT Date

Nitrification Field: No Fields 1 Square Feet 1200 Linear Feet 400

No-Lines 3 Trench Width 36" Trench Depth 24-30" Gravel Depth 12"

☑ New System ☐ Repair System Type: I, II, III, IV, V, VI

System Description: gravity conventional

Repair System Description: same

Maintenance Agreement Required: ☐ Yes ☑ No

☐ House/Mod. Home ☑ Mobile Home ☐ Business ☐ Other

No. Bedrooms 3 No. Bathrooms 2 No. Employees

☐ Slab ☑ Crawl Space ☐ Basement w/plumbing ☐ Basement wo/plumbing

Garbage Disposal: ☐ Yes ☑ No

Auto. Dishwasher: ☐ Yes ☑ No


Auto. Washing Machine: ☑ Yes ☐ No

Other

Comments Mobile home already set up on site

10/5/93 Well not installed as of this date. DKH

INITIAL SITE SKETCH

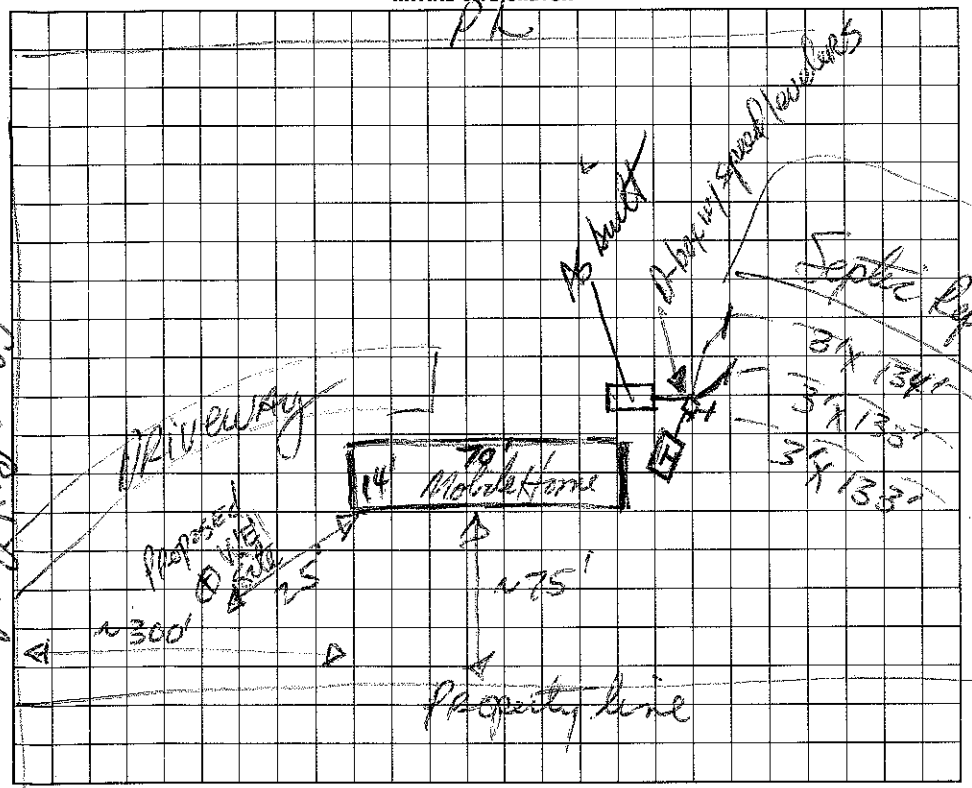

AS BUILT SKETCH

As shown on initial sketch except tank oriented as shown.

4

I understand that this permit can be suspended or revoked if any false information is supplied toward securing the permit/any unauthorized changes are made to the site/any unauthorized changes are made in the installation of the system. Improvement Permit is valid for 60 months from date of issuance.

Signed: Robert Jordan

Improvement Permit by: Dave Hanson, RS date 9/27/93

Existing System Inspection by: date

Installed by: Powell Backhoe Service, Cleveland NC (704) 278-4720

Certificate of Completion by: Dave Hanson, RS date 10/5/93

Operation Permit by: date

HEALTH DEPT. COPY: WHITE | INSPECTION COPY (FINAL): GREEN | OWNER COPY (FINAL): YELLOW | INSPECTION COPY (INITIAL): PINK | OWNER COPY (INITIAL): GOLD