4656 036375

IREDELL COUNTY HEALTH DEPARTMENT

STATESVILLE 704-878-5305 MOORESVILLE 704-664-5281

IMPROVEMENT PERMIT / CERTIFICATE OF COMPLETION / OPERATION PERMIT / EXISTING SYSTEM INSPECTION

PROPERTY DESCRIPTION NO. 17168 DATE Oct. 29, 93 TAX MAP NO. 2417A2 Watershed: ☐ Yes ☐ No

OWNER OR CONTRACTOR Don Jasper PHONE: Business Home

ADDRESS 348 W. McFarland Ave, Mooresville

LOCATION 115 S. TR Water Lynn Rd. X RR ~¼ mile on right

SUBDIVISION Jasper prop. BLOCK / SECTION LOT A LOT AREA 100'X200' SITE CLASS I5 par I9B DESIGN FLOW 360 gpd L.T.A.R. .3

Septic Tank: 1000 Gallons; STB 358 ACP Date 11-10-93
Pump Tank: Gallons; PT Date
Pump Make: Model Serial No.
Nitrification Field: No Fields 2 Square Feet 1200 Linear Feet 400
No Lines 6 (3+3) Trench Width 36" Max Trench Bottom Depth 36" Gravel Depth 12"

☑ New System ☐ Repair System Type: I, II, III, IV, V, VI
System Description: gravity conventional
Repair System Description: PABPS
Maintenance Agreement Required: ☐ Yes ☑ No


☑ House/Mod. Home No. Bedrooms 3
☐ Mobile Home No. Bathrooms 1
☐ Business No. Employees
☐ Other
☐ Slab ☑ Crawl Space ☐ Basement w/plumbing ☐ Basement wo/plumbing

Water Supply:
☑ Individual
☐ Community
☐ Public

Comments: Exit plumbing at grade.

Comments: House not started as of 12/30/93. Well not installed either.

INITIAL SITE SKETCH

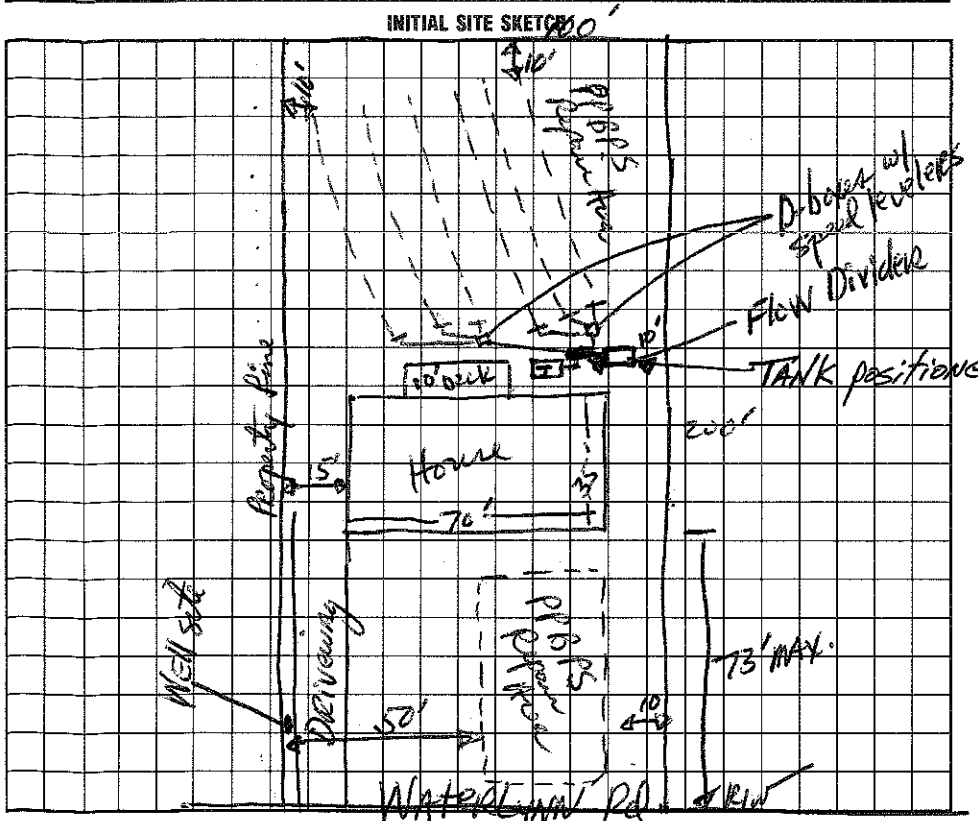

AS BUILT SKETCH

As shown on initial sketch except slight tank repositioning

I understand that this permit can be suspended or revoked if any false information is supplied toward securing the permit/any unauthorized changes are made to the site/any unauthorized changes are made in the installation of the system. Improvement Permit is valid for 60 months from date of issuance.

Signed:

Improvement Permit by: David R. Hinson, RS date 10/29/93

Existing System Inspection by: date

Installed by: Owner

Certificate of Completion by: David R. Hinson, RS date 12/30/93

Operation Permit by: date

HEALTH DEPT. COPY: WHITE INSPECTION COPY (FINAL): GREEN OWNER COPY (FINAL): YELLOW INSPECTION COPY (INITIAL): PINK OWNER COPY (INITIAL): GOLD