IREDELL COUNTY HEALTH DEPARTMENT

STATESVILLE 704-878-5305 MOORESVILLE 704-664-5281

IMPROVEMENT PERMIT / AUTHORIZATION TO CONSTRUCT / OPERATION PERMIT / EXISTING SYSTEM INSPECTION

PERMIT # REPAIR PIN # 4656-06-0963 DATE 5-4-11

OWNER or APPLICANT DAVID MURPHY PHONE: Business 704-965-8928 Home:

OWNER or APPLICANT ADDRESS 141 HUNTINGTON LN.

LOCATION / DIRECTIONS 21 TO HUNTINGTON

SUBDIVISION HUNTINGTON WOODS BLOCK / SECTION LOT # 18 LOT AREA .45Ac DESIGN FLOW 360 L.T.A.R.

Septic Tank 1050 Gallons: STB TW-1050 Date

Pump Tank Gallons: P T Date

Pump Make Model Serial #

Nitrification Field No Fields EXISTING No Lines Linear Feet 200'

Trench Width Max. Trench Bottom Depth Gravel Depth 10"

☐ New System ☒ Repair ☐ Expansion System Type I II III IV V VI

System Description: TANK

Repair System Description:

Maintenance Agreement Required ☐ YES ☒ NO

☒ GRAVITY ☐ PRESSURE

☒ Residence No. Bedrooms 3

☐ Business No. Persons

☐ Other No. Employees

☐ Slab ☐ Crawl Space


☐ Basement w/plumbing ☐ Basement w/o plumbing

Water Supply: ☒ Private ☐ Public ☐ Community


Comments / Conditions

Comments / Conditions

INITIAL SITE SKETCH

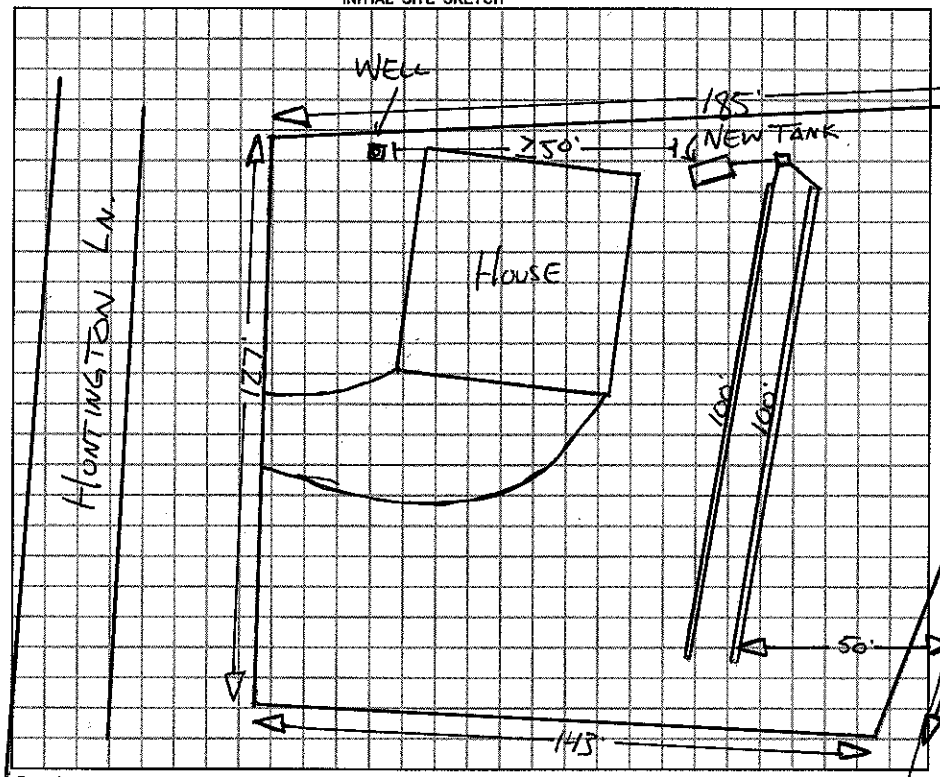

AS BUILT SKETCH

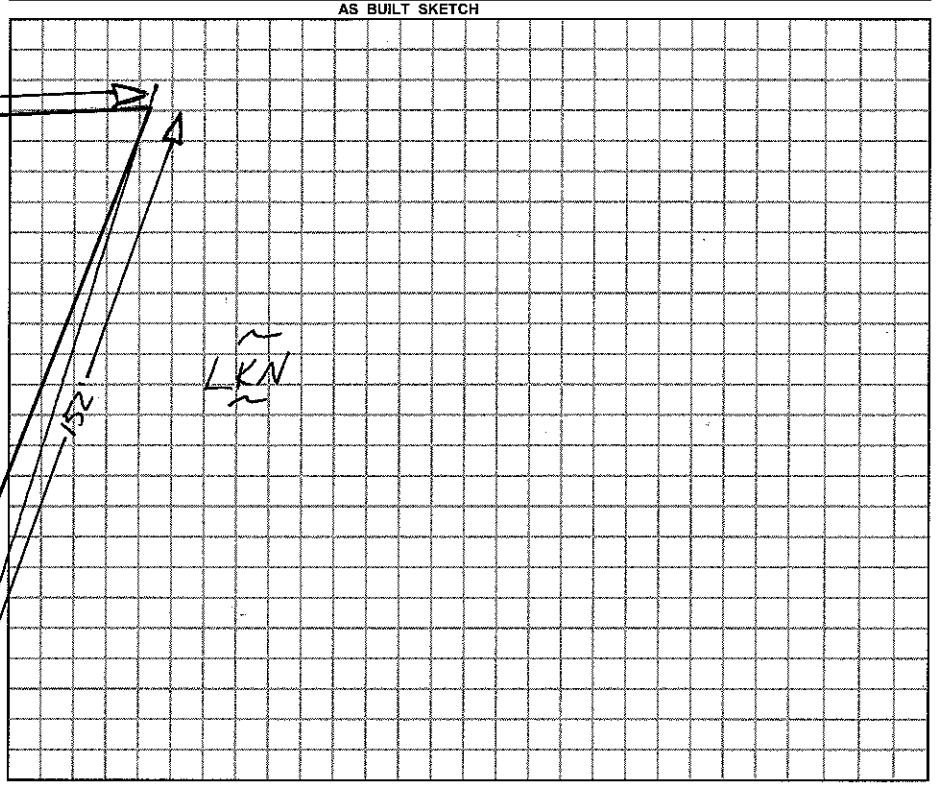

Permit can be suspended or revoked if any false information is supplied toward securing the permit / any unauthorized changes are made to the site / any unauthorized changes are made in the installation of the system.

☐ *IMPROVEMENT PERMIT w / plat valid without expiration.* ☐ *IMPROVEMENT PERMIT w / site plan valid for 60 mos.* ☐ *AUTHORIZATION TO CONSTRUCT valid for period equal to IMPROVEMENT PERMIT-not to exceed 60 mo.*

Owner / Applicant Signature: Date

Improvement Permit by: REHS Date 5-4-11

Authorzation to Construct by: REHS Date 5-4-11

YOU SHOULD CONTACT A LOCATOR SERVICE PRIOR TO ANY EXCAVATION.

Installed by: Tommy Fey

Operation Permit by: REHS Date: 5-4-11

Existing System Inspected by: Date:

WHITE COPY Environmental Health YELLOW COPY (Final) Owner / Applicant PINK COPY (Initial) Owner / Applicant