IREDELL COUNTY HEALTH DEPARTMENT

Quality inspection to Construct 4656-11-4251

STATESVILLE 704-878-5305 MOORESVILLE 704-664-5281

IMPROVEMENT PERMIT / ~~CERTIFICATE OF COMPLETION~~ / OPERATION PERMIT / EXISTING SYSTEM INSPECTION

PROPERTY DESCRIPTION NO. 26247 DATE 3/20/97 TAX MAP NO. 4656115125 (Pt.) Watershed: ☐ Yes ☒ No

OWNER OR CONTRACTOR Don Wembish PHONE: Business _____ Home 664-7727

ADDRESS PO Box 733 Mooresville, NC. 28115

LOCATION Mocksville Hwy (1155) on (R) past Waterlyn Rd., on (R) just before Leslie Loop.

SUBDIVISION Eastway BLOCK / SECTION _____ LOT 2 LOT AREA 1.15 AC SITE CLASS PS DESIGN FLOW 360 L.T.A.R. .25

Septic Tank: 1000 Gallons; STB 821 Date 3/1/97

Pump Tank: _____ Gallons; PT _____ Date _____

Pump Make: _____ Model _____ Serial No. _____

Nitrification Field: No Fields 1 Square Feet 1440 Linear Feet 480

No Lines 5 Trench Width 36" Max Trench Bottom Depth 30" Gravel Depth 12"

☒ New System ☐ Repair System Type: I, II, III, IV, V, VI

System Description: CONV - DIST BOX

Repair System Description: SAME

Maintenance Agreement Required: ☐ Yes ☒ No

☐ House/Mod. Home ☒ Mobile Home ☐ Business ☐ Other

No. Bedrooms 3 No. Bathrooms 2 No. Employees _____


☐ Slab ☒ Crawl Space ☐ Basement w/plumbing ☐ Basement wo/plumbing

Water Supply: ☐ Individual ☐ Community ☐ Public


Comments:

Comments:

INITIAL SITE SKETCH

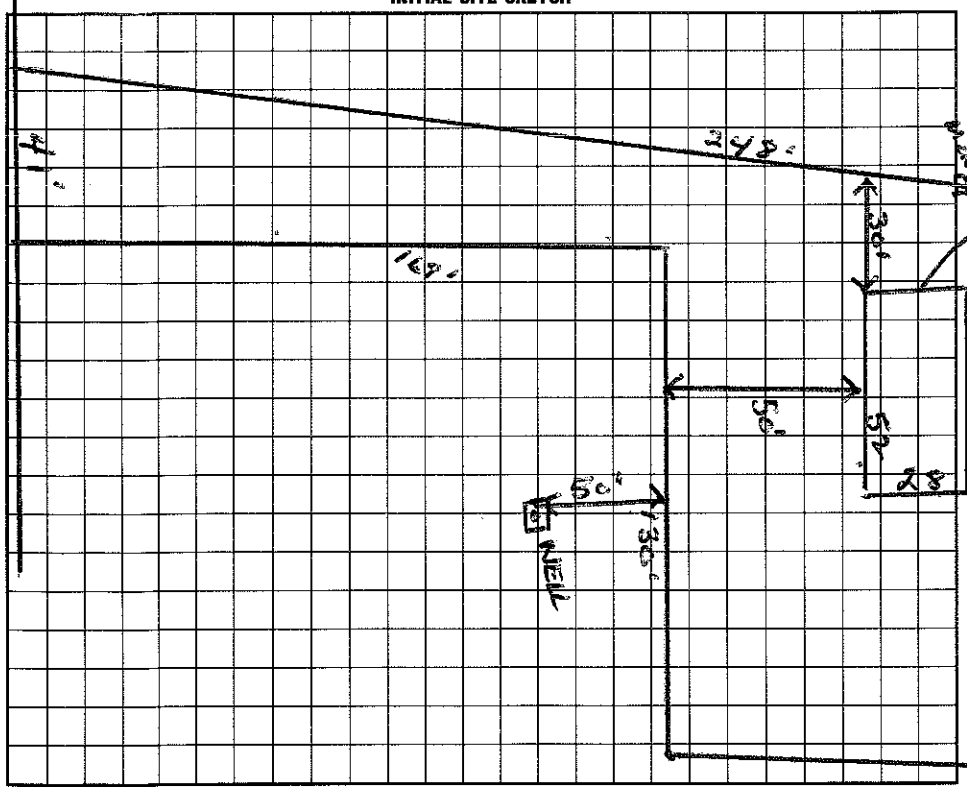

AS BUILT SKETCH

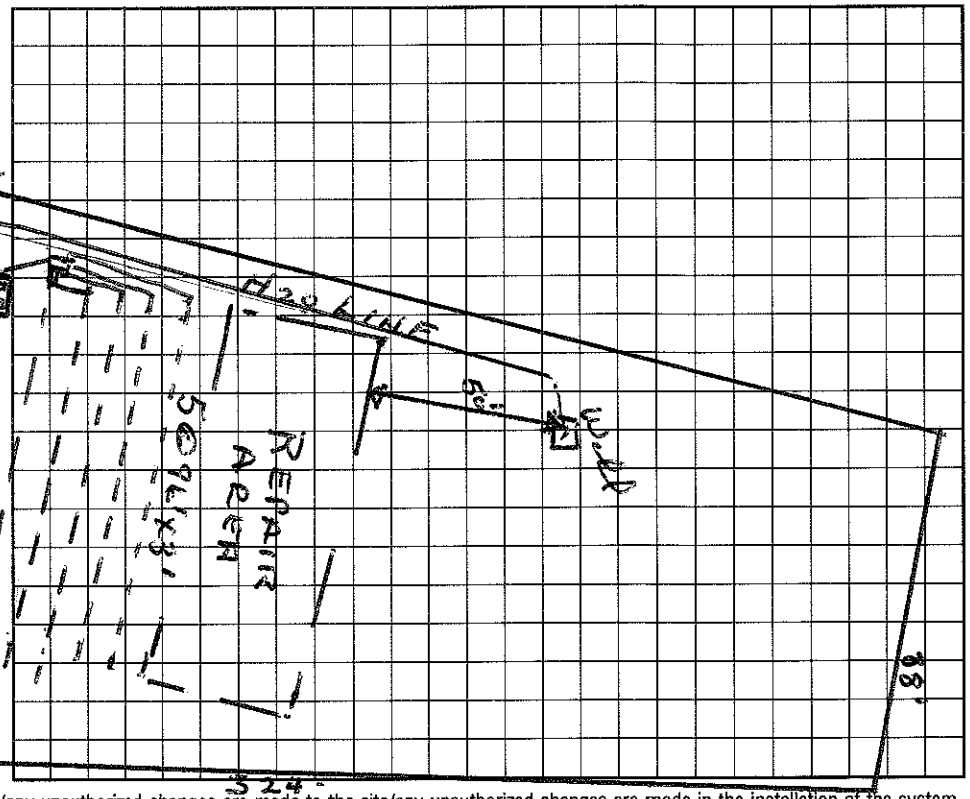

I understand that this permit can be suspended or revoked if any false information is supplied toward securing the permit/any unauthorized changes are made to the site/any unauthorized changes are made in the installation of the system. Improvement Permit is valid for 60 months from date of issuance.

Signed: ✕ Don Wembish

Improvement Permit by: Wesley Sparks R.S. date 3/20/97

Existing System Inspection by: Wesley Sparks RS date 3/20/97

Installed by: D+M Enterprises

Certificate of Completion by: Wesley Sparks R.S. date 4/3/97

Operation Permit by: Wesley Sparks R.S. date 4/3/97

Add 6"

HEALTH DEPT. COPY: WHITE INSPECTION COPY (FINAL): GREEN OWNER COPY (FINAL): YELLOW INSPECTION COPY (INITIAL): PINK OWNER COPY (INITIAL): GOLD