IREDELL COUNTY HEALTH DEPARTMENT

STATESVILLE 704-878-5305 MOORESVILLE 704-664-5281

4656 11 6848

IMPROVEMENT PERMIT / CERTIFICATE OF COMPLETION / OPERATION PERMIT / EXISTING SYSTEM INSPECTION

PROPERTY DESCRIPTION NO. 18374 DATE May 4, 94 TAX MAP NO. 2H5A-156 (part of)

OWNER OR CONTRACTOR Robert P. Bass PHONE: Business _____ Home _____ Watershed: ☐ Yes ☐ No

ADDRESS Rt 11, Box 466 Mooresville

LOCATION 115 S. TR Waterlynn Rd. X RR on left behind 2nd dwelling

SUBDIVISION _____ BLOCK / SECTION _____ LOT _____ LOT AREA 1½ Ac SITE CLASS PS DESIGN FLOW 360 gpd L.T.A.R. .3

Septic Tank: 1000 Gallons; STB TP 1012 Date 4-13-94

Pump Tank: _____ Gallons; PT _____ Date _____

Pump Make: _____ Model _____ Serial No. _____

Nitrification Field: No. Fields 1 Square Feet 1200 Linear Feet 400

No. Lines 4-5 Trench Width 36" Max Trench Bottom Depth 36" Gravel Depth 12"

☑ New System ☐ Repair System Type: I, II, III, IV, V, VI

System Description: gravity Conventional

Repair System Description: Same

Maintenance Agreement Required: ☐ Yes ☑ No

☐ House/Mod. Home No. Bedrooms 3

☑ Mobile Home No. Bathrooms 2

☐ Business No. Employees _____

☐ Other _____


☐ Slab ☑ Crawl Space ☐ Basement w/plumbing ☐ Basement wo/plumbing

Water Supply: ☑ Individual ☐ Community ☐ Public


Comments:

Comments: Well not installed as of 7/13/94 Mobile Home also not set up as of this date, 7-13-94

INITIAL SITE SKETCH

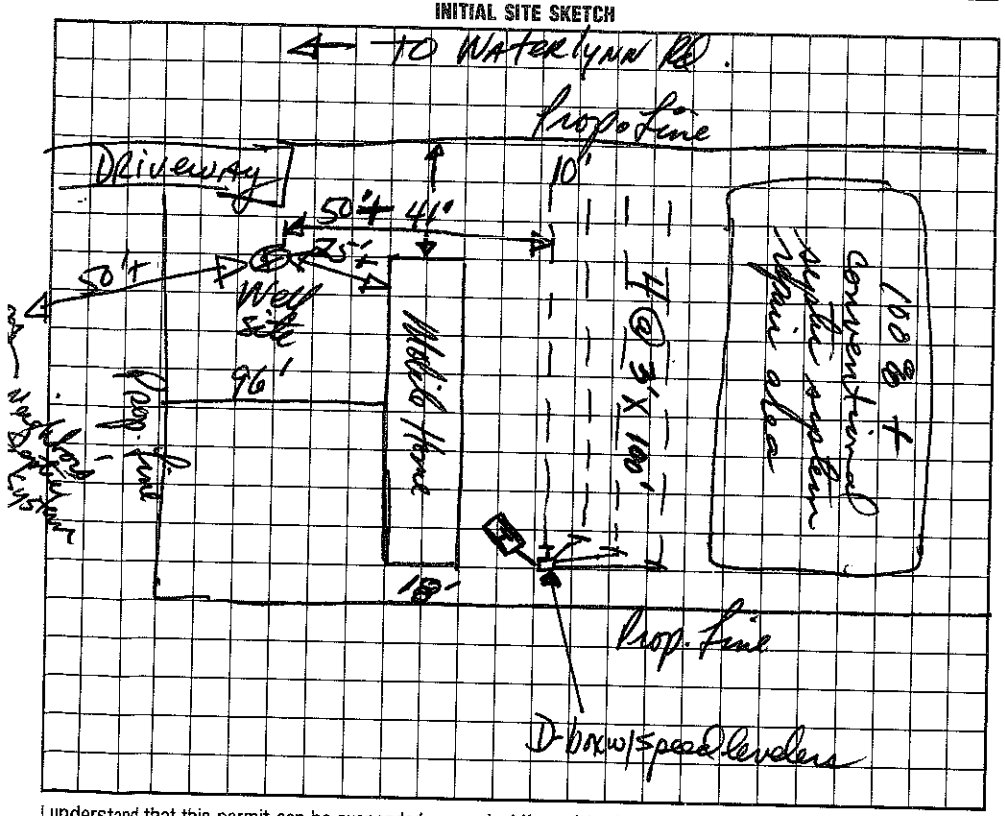

AS BUILT SKETCH

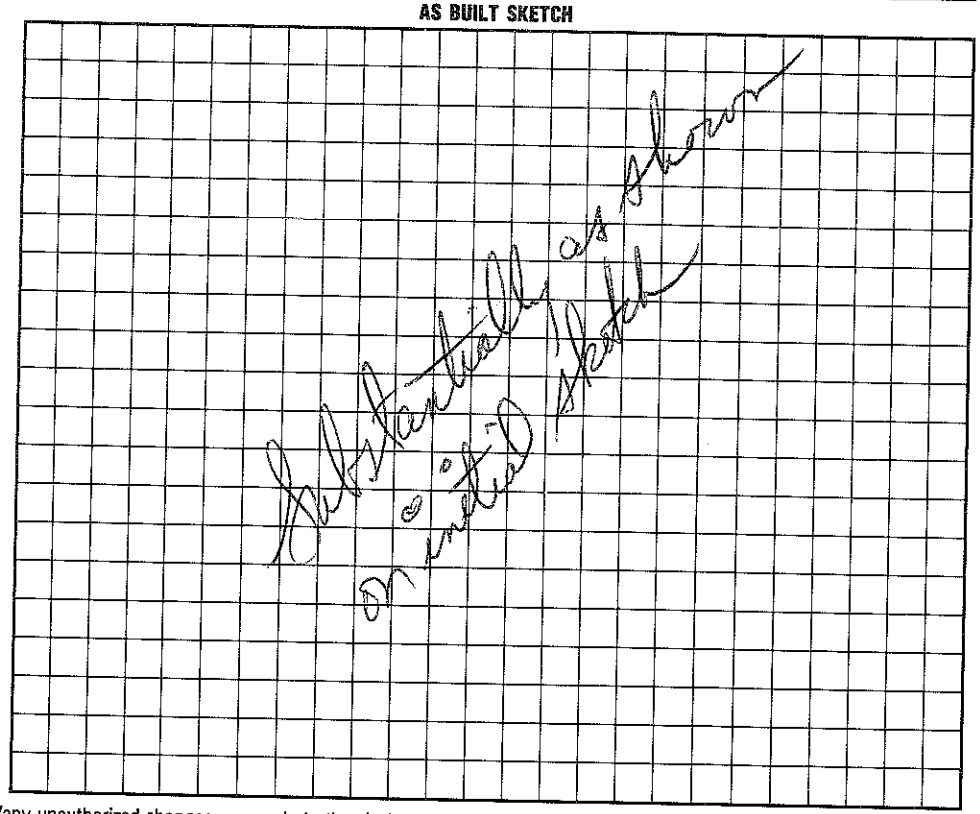

I understand that this permit can be suspended or revoked if any false information is supplied toward securing the permit/any unauthorized changes are made to the site/any unauthorized changes are made in the installation of the system. Improvement Permit is valid for 60 months from date of issuance.

Signed: X Bruce Bass

Improvement Permit by: David R. Hinson, RS date 5/4/94

Existing System Inspection by: _____ date _____

Installed by: JC's Backhoe Service

Certificate of Completion by: David R. Hinson RS date 7/13/94

Operation Permit by: _____ date _____

HEALTH DEPT. COPY: WHITE INSPECTION COPY (FINAL): GREEN OWNER COPY (FINAL): YELLOW INSPECTION COPY (INITIAL): PINK OWNER COPY (INITIAL): GOLD