IREDELL COUNTY HEALTH DEPARTMENT

STATESVILLE 704-878-5305 MOORESVILLE 704-664-5281

IMPROVEMENT PERMIT / AUTHORIZATION TO CONSTRUCT / OPERATION PERMIT / EXISTING SYSTEM INSPECTION

PERMIT # REPAIR PIN # 4656 11 ~~5554~~ 7432 DATE 5/4/09

OWNER or APPLICANT MIKE SHERRIL PHONE: Business Home:

OWNER or APPLICANT ADDRESS 1312 MECK HWY 5 MOORESVILLE, NC. 28115

LOCATION / DIRECTIONS SAME

SUBDIVISION No BLOCK / SECTION No LOT # No LOT AREA EXIST. DESIGN FLOW 360 L.T.A.R. - 3

Septic Tank 1000 Gallons: STB 312 Date 12/11/08

Pump Tank Gallons: P T Date

Pump Make Model Serial #

Nitrification Field No Fields 1 No Lines 5 Linear Feet 300

Trench Width 3' Max. Trench Bottom Depth 3' Gravel Depth No

☐ New System ☒ Repair ☐ Expansion System Type I ☒ III IV V VI

System Description:

Repair System Description: GRAVITY - 25% REDUCTION

Maintenance Agreement Required ☐ YES ☐ NO

☒ GRAVITY ☐ PRESSURE


☒ Residence No. Bedrooms 3 ☐ Business No. Persons ☐ Other No. Employees ☐ Slab ☒ Crawl Space ☐ Basement w/plumbing ☐ Basement w/o plumbing

Water Supply: ☒ Private ☐ Public ☐ Community

Comments / Conditions 50' FROM WELL WITH EVERYTHING CLEANOUTS AT PROPER INTERVALS.

Comments / Conditions —— OLD WATER LINE REROUTED OUT OF DRAIN FIELD;

INITIAL SITE SKETCH

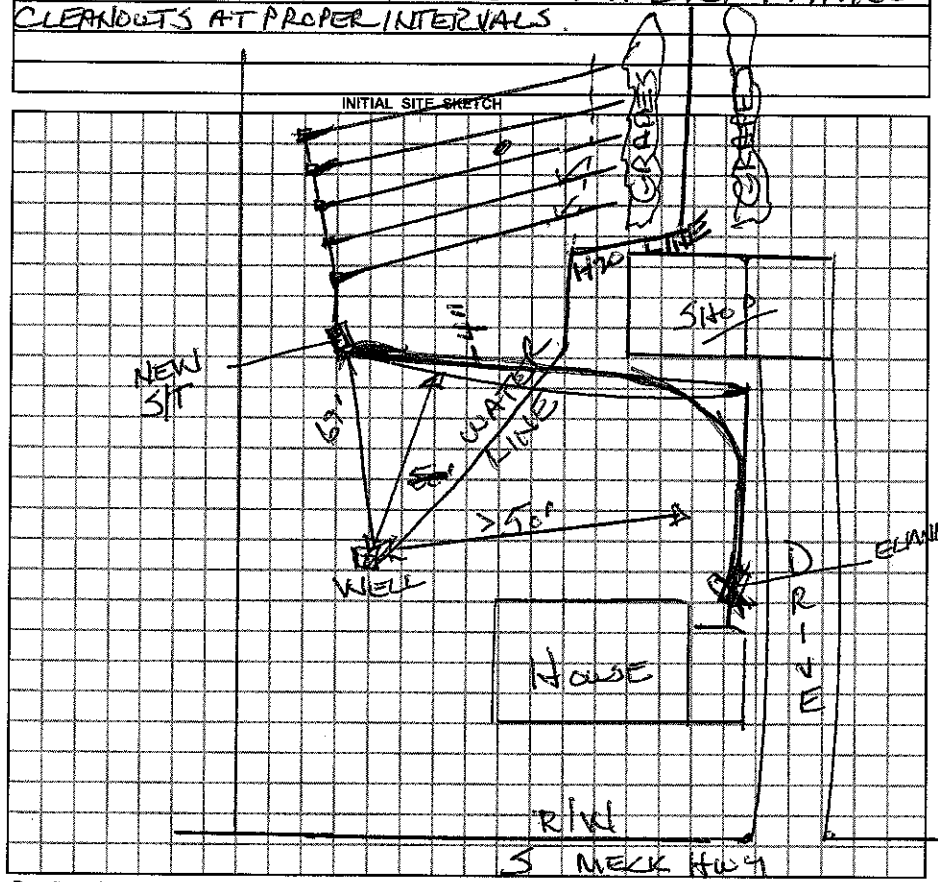

AS BUILT SKETCH

Permit can be suspended or revoked if any false information is supplied toward securing the permit / any unauthorized changes are made to the site / any unauthorized changes are made in the installation of the system.

☐ *IMPROVEMENT PERMIT w / plat valid without expiration.* ☐ *IMPROVEMENT PERMIT w / site plan valid for 60 mos.* ☐ *AUTHORIZATION TO CONSTRUCT valid for period equal to IMPROVEMENT PERMIT-not to exceed 60 mo.*

Owner / Applicant Signature: [signature] Date 5/6/09

Improvement Permit by: Wesley Sparks RS Date 5/4/09

Authorization to Construct by: Wesley Sparks RS Date 5/4/09

YOU SHOULD CONTACT A LOCATOR SERVICE PRIOR TO ANY EXCAVATION.

Installed by: FJ Enviro

Operation Permit by: Wesley Sparks RS. Date: 8/24/09

Existing System Inspected by: Date:

WHITE COPY Environmental Health YELLOW COPY (Final) Owner / Applicant PINK COPY (Initial) Owner / Applicant