4656125354

IREDELL COUNTY HEALTH DEPARTMENT

STATESVILLE 704-878-5305 MOORESVILLE 704-664-5281

IMPROVEMENT PERMIT / CERTIFICATE OF COMPLETION / OPERATION PERMIT / EXISTING SYSTEM INSPECTION

PROPERTY DESCRIPTION NO. _____ DATE July 23, '93 TAX MAP NO. _____

OWNER OR CONTRACTOR Jerry Puckett PHONE: Business _____ Home 663-4628

ADDRESS Rt 11 Box 484 Mooresville

LOCATION 115 S. to Watkelynn Rd x RR ½-¾ mile on left

SUBDIVISION _____ BLOCK / SECTION _____ LOT _____ LOT AREA _____ SITE CLASS. _____ L.T.A.R. 2.3-.4

Water Supply: ☑ Individual ☐ Community ☐ Public

Septic Tank: Existing Gallons; STB _____ Date _____

Pump Tank: _____ Gallons; PT _____ Date _____

Nitrification Field: No. Fields 1 Square Feet 750 Linear Feet 250

No. Lines 5 in bed Trench Width 15" Trench Depth 36" Gravel Depth 18"+

☐ New System ☑ Repair System Type: I, II, III, IV, V, VI

System Description: gravity bed

Repair System Description: same

Maintenance Agreement Required: ☐ Yes ☑ No

☑ House/Mod. Home No. Bedrooms 2+

☐ Mobile Home No. Bathrooms 1-2

☐ Business No. Employees _____

☐ Other _____

☐ Slab ☑ Crawl Space ☐ Basement w/plumbing ☐ Basement wo/plumbing

Garbage Disposal: ☐ Yes ☑ No


Auto. Dishwasher: ☐ Yes ☐ No

Auto. Washing Machine: ☑ Yes ☐ No


Other _____

Comments All plumbing from house to go to septic tank.

INITIAL SITE SKETCH

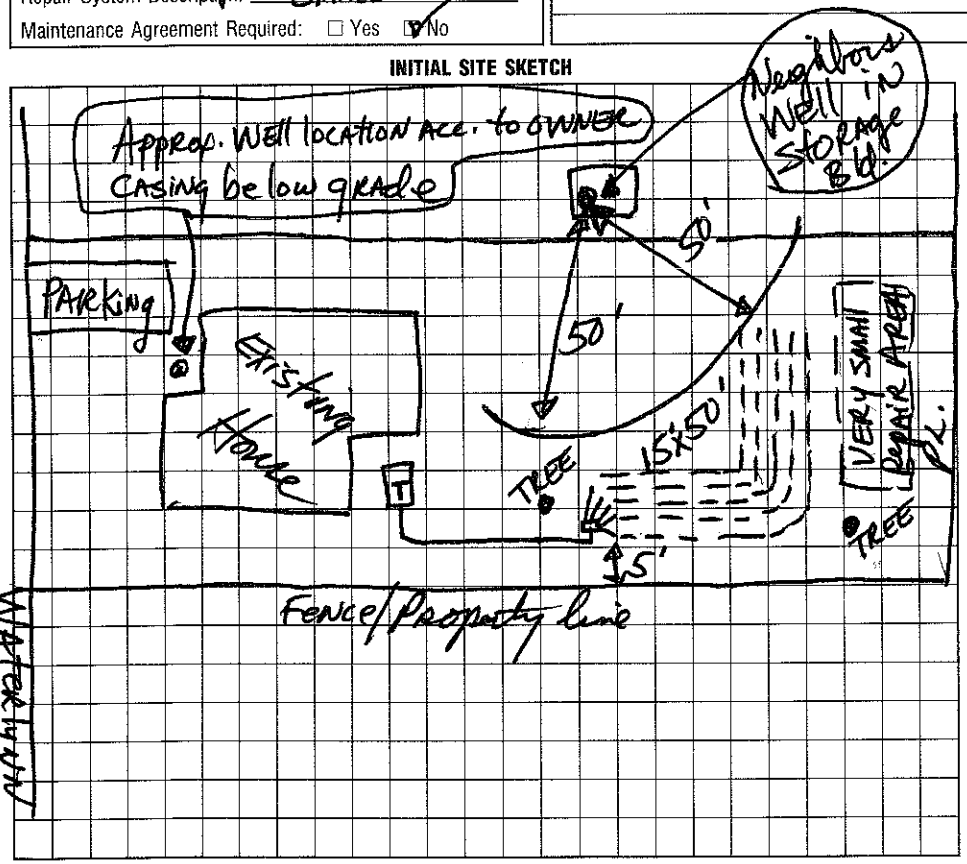

AS BUILT SKETCH

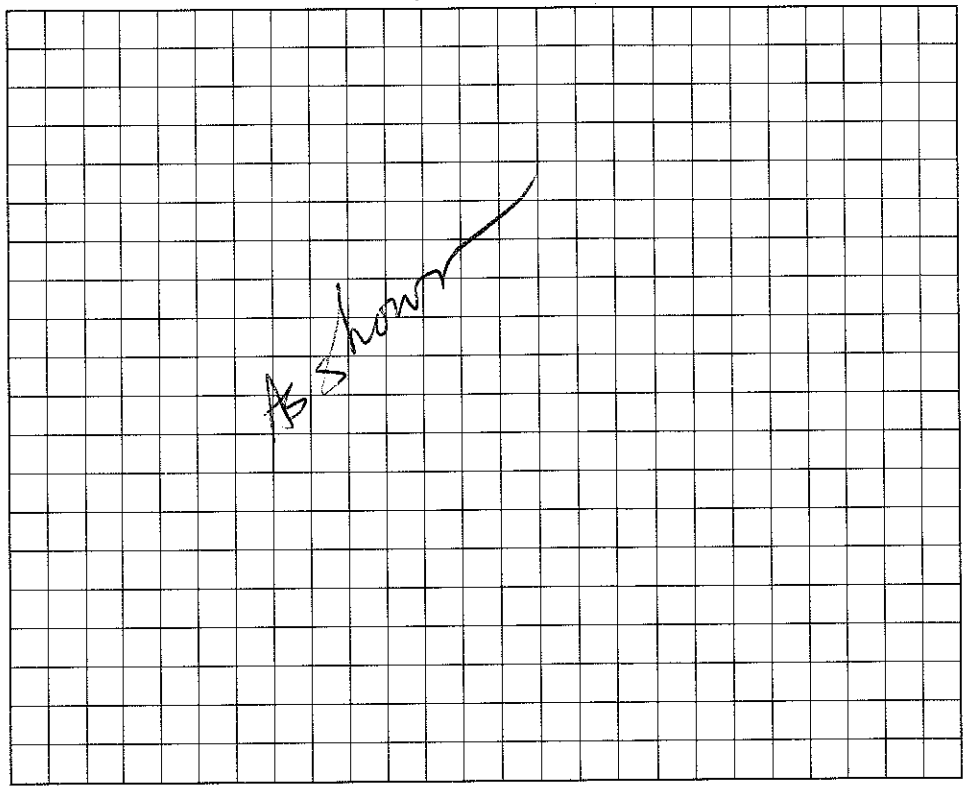

I understand that this permit can be suspended or revoked if any false information is supplied toward securing the permit/any unauthorized changes are made to the site/any unauthorized changes are made in the installation of the system. Improvement Permit is valid for 60 months from date of issuance.

Signed _____

Improvement Permit by: Jarrod L. Hinson, RS date 7/23/93

Existing System Inspection by: _____ date _____

Installed by: J.R. Bowles

Certificate of Completion by: D.L. Hinson, RS date 1-25-95

Operation Permit by: _____ date _____

HEALTH DEPT. COPY: WHITE INSPECTION COPY (FINAL): GREEN OWNER COPY (FINAL): YELLOW INSPECTION COPY (INITIAL): PINK OWNER COPY (INITIAL): GOLD