309-4272 2100

IREDELL COUNTY HEALTH DEPARTMENT - *ENVIRONMENTAL HEALTH* ☐ STATESVILLE OFFICE 704-878-5305 ☒ MOORESVILLE OFFICE 704-664-5281

IMPROVEMENT PERMIT / AUTHORIZATION TO CONSTRUCT / OPERATION PERMIT / EXISTING SYSTEM INSPECTION

PERMIT # REPAIR PIN # 4656-12-8140 DATE 9-21-11

OWNER JAMES POTTS APPLICANT: SAME PHONE: Home/Cell # 704-589-5009 Business #

SITE ADDRESS 240 E. WATERLYNN RD. OWNER / APPLICANT ADDRESS 143 LONG COVE, NEW LONDON 28127

SITE DIRECTIONS 115 S. TR WATERLYNN 1ST ON L

SUBDIVISION BLOCK / SECTION LOT # LOT AREA .81 AC DESIGN FLOW 240 L.T.A.R. .25

Septic Tank 1000 Gallons: STB 794 Date 10-22-11 ☐ New System ☒ Repair ☐ Expansion System Type I II (III) IV V VI

Pump Tank Gallons: P T Date System Description:

Pump Make Model Serial # Repair System Description: 25% RED.

No. Nitrification Fields: 1 No. Lines 5 Linear Feet 250 Maintenance Agreement Required ☐ YES ☒ NO

Trench Width 36" Max. Trench Bottom Depth * 12" * Gravel Depth ☒ GRAVITY ☐ PRESSURE


☒ Residence No. Bedrooms 2 ☐ Business No. Persons ☐ Other No. Employees ☐ Slab ☒ Crawl Space ☐ Basement w/plumbing ☐ Basement w/o plumbing

Water Supply: ☒ Private ☐ Public ☐ Community

Comments / Conditions * 12" MAX DEPTH * BRING IN 6" COVER TYPE I, II, III SOILS

12/12/11 Checked New ST & Drainfield (Quick 4) (lowest line 31ft from ok 2" well must be abandoned prior to use

INITIAL SITE SKETCH

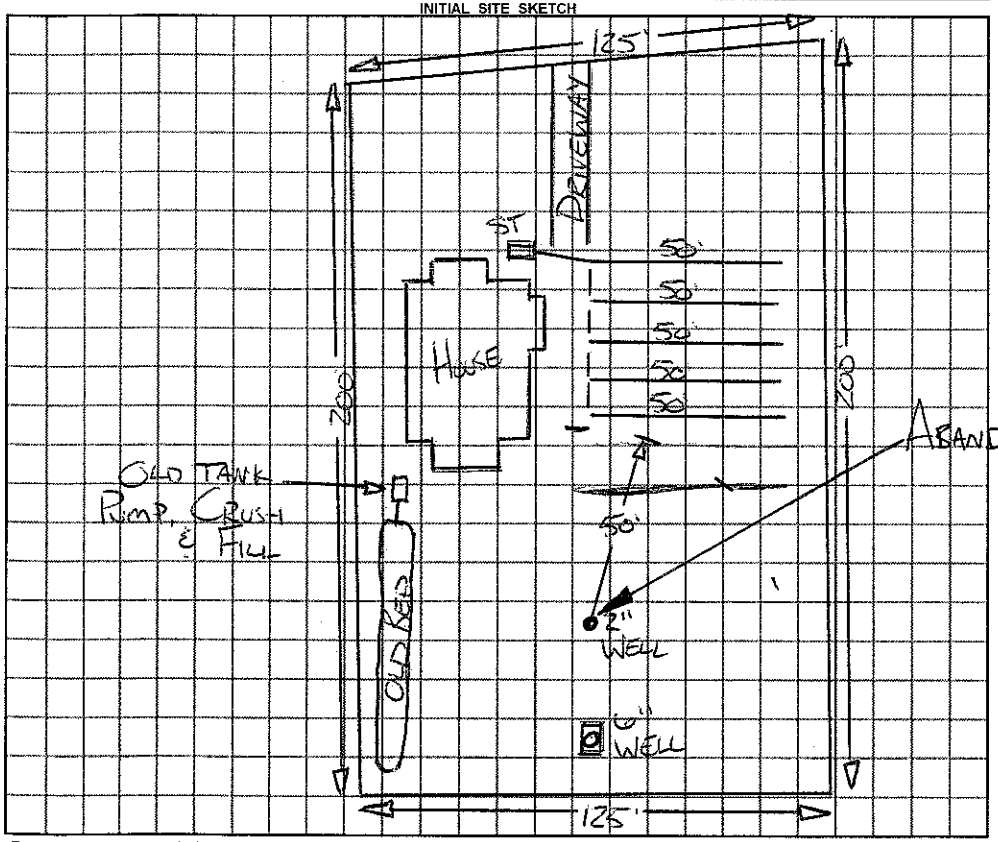

AS BUILT SKETCH

1"=50'

Permit can be suspended or revoked if any false information is supplied toward securing the permit / any unauthorized changes are made to the site / any unauthorized changes are made in the installation of the system.

☐ ***IMPROVEMENT PERMIT*** with plat valid without expiration. ☐ ***IMPROVEMENT PERMIT*** with plat ~~valid without expiration~~ site plan valid 60 mo. ☒ ***AUTHORIZATION TO CONSTRUCT*** valid for period equal to IMPROVEMENT PERMIT--not to exceed 60 mo.

Owner / Applicant Signature: Date 9-27-11 Installed by: Stanley Septic

IMPROVEMENT PERMIT by: R. A. Ellis ***REHS*** Date 9-21-11 OPERATION PERMIT by: R. A. Ellis ***REHS*** Date 1-10-12

AUTHORIZATION TO CONSTRUCT by: R. A. Ellis ***REHS*** Date 9-21-11 Existing System Inspected by: ***REHS*** Date

YOU SHOULD CONTACT A LOCATOR SERVICE PRIOR TO ANY EXCAVATION

White Copy -- Environmental Health YELLOW COPY (Final) Owner / Applicant PINK COPY (Initial) Owner / Applicant