IREDELL COUNTY HEALTH DEPARTMENT

STATESVILLE 704-878-5305 MOORESVILLE 704-664-5281

IMPROVEMENT PERMIT / AUTHORIZATION TO CONSTRUCT / OPERATION PERMIT / EXISTING SYSTEM INSPECTION

PERMIT# 101506 PIN# 4656159261 DATE 11-27-02

OWNER OR CONTRACTOR David Miller PHONE: Business Home 664-3106

ADDRESS 242 Foursquare Rd Mooresville NC 28115

LOCATION Hwy 115 South TR Foursquare to end of pavement on right

SUBDIVISION BLOCK / SECTION LOT LOT AREA SITE CLASS. PS DESIGN FLOW 360gpd L.T.A.R.

Septic Tank: Existing Gallons; STB Date

Pump Tank: Gallons; PT Date

Pump Make: Model Serial No.

Nitrification Field: No Fields 1 Square Feet Linear Feet ~75'

No Lines Bed Trench Width ~7½' Max. Trench Bottom Depth Existing Gravel Depth

☐ New System ☐ Repair System Type: I (II) III, IV, V, VI

System Description: Existing Gravity Conventional

Repair System Description:

Maintenance Agreement Required: ☐ Yes ☒ No

☐ House/Mod. Home No. Bedrooms 3

☐ Mobile Home No. Bathrooms

☐ Business No. Employees

☐ Other


☐ Slab ☒ Crawl Space ☐ Basement w/plumbing ☐ Basement wo/plumbing

Water Supply: ☒ Individual ☐ Public/Shared ☐ Community

Comments/Conditions: Existing Septic System appears to be Functioning okay at time of inspection.

Comments/Conditions:

INITIAL SITE SKETCH ☆ Not to Scale

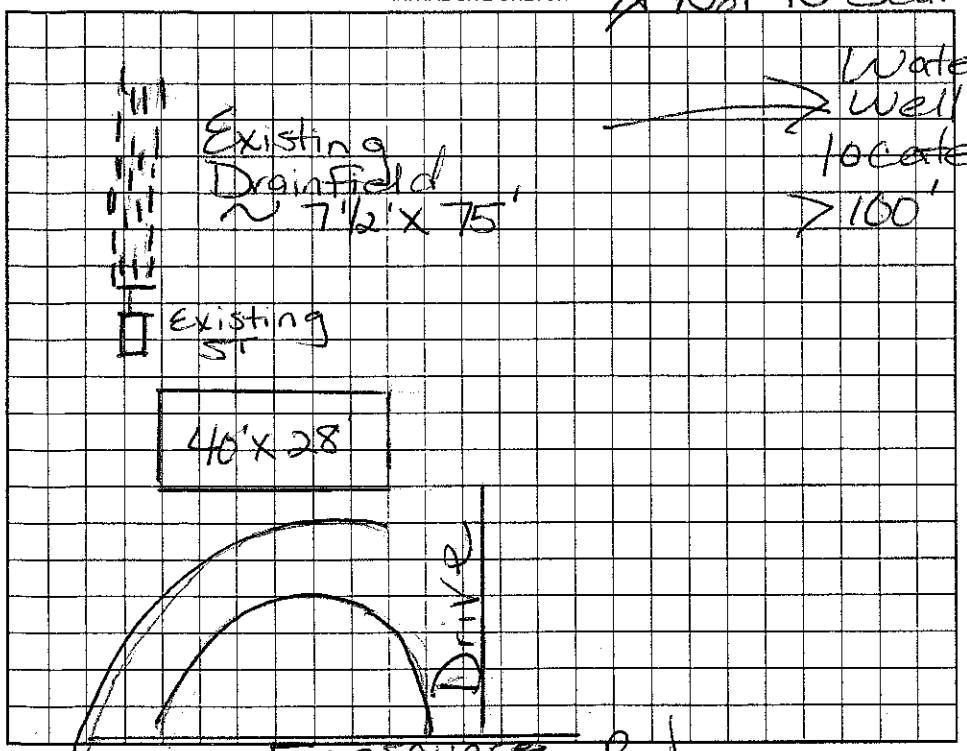

AS BUILT SKETCH

Permit can be suspended or revoked if any false information is supplied toward securing the permit/any unauthorized changes are made to the site/any unauthorized changes are made in the installation of the system. Improvement Permit with plat valid without expiration. Improvement Permit with site plan valid for sixty months. Authorization to Construct is valid for a period equal to that of Improvement Permit – not to exceed sixty months.

Signed David Miller date Installed by:

Improvement Permit by: Maina H. Dotson RS date 11/27/02 Operation Permit by: date

Authorization to Construct by: date Existing System Inspection by: Maina H. Dotson RS date 11/27/02

HEALTH DEPT. COPY: WHITE OWNER COPY (FINAL): YELLOW OWNER COPY (INITIAL): PINK