4056-16-4845

IREDELL COUNTY HEALTH DEPARTMENT

STATESVILLE 704-878-5305 MOORESVILLE 704-664-5281

IMPROVEMENT PERMIT / AUTHORIZATION TO CONSTRUCT / OPERATION PERMIT / EXISTING SYSTEM INSPECTION

PERMIT# Repair PIN# DATE 6/21/05

OWNER OR CONTRACTOR Kenneth Rogers PHONE: Business Home 704-664-3927

ADDRESS 139 Deerwood Ln Mooresville 28117

LOCATION 21S, TL Deerwood, on Lt

SUBDIVISION Deerwood BLOCK / SECTION LOT 5 LOT AREA 0.947AC SITE CLASS. PS DESIGN FLOW 360 L.T.A.R. —

Septic Tank: 1000 Gallons; STB 750 Date 4-18-05
Pump Tank: Gallons; PT Date
Pump Make: Model Serial No.
Nitrification Field: No Fields Square Feet Linear Feet 300 Ex
No Lines 3 Trench Width Max Trench Bottom Depth Gravel Depth 10"

☐ New System ☒ Repair System Type: I (II) III, IV, V, VI
System Description:
Repair System Description: Gravity Conventional
Maintenance Agreement Required: ☐ Yes ☒ No

☒ House/Mod. Home No. Bedrooms 3
☐ Mobile Home No. Bathrooms
☐ Business No. Employees
☐ Other

☐ Slab ☐ Crawl Space ☐ Basement w/plumbing ☐ Basement wo/plumbing


Water Supply: ☒ Individual ☐ Public ☐ Community

Comments:/Conditions: Replacing Septic Tank - Pump + Filter Old Tank

Comments:/Conditions: Red poly loK filter Installed new tank with risers and new D-Box with first line feeding first and dropping to speed levelers for next 2 lines

New tank installed to right of old tank (when facing yard) so they are in reversed position from initial sketch

INITIAL SITE SKETCH

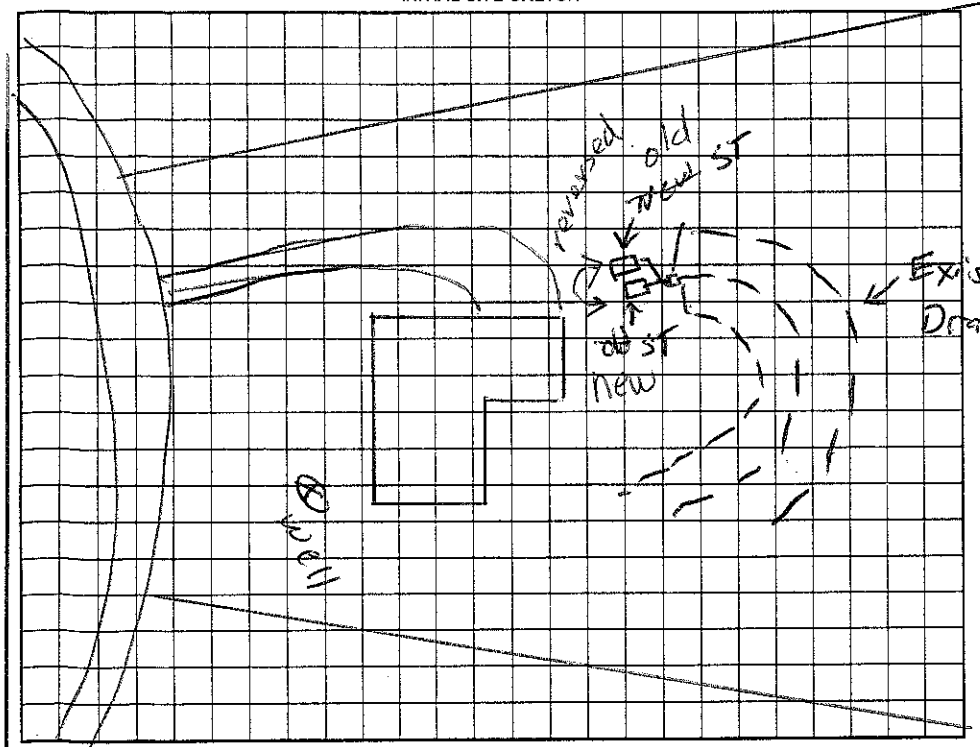

AS BUILT SKETCH

Deer wood

Permit can be suspended or revoked if any false information is supplied toward securing the permit/any unauthorized changes are made to the site/any unauthorized changes are made in the installation of the system. Improvement Permit with plat valid without expiration. Improvement Permit with site plan valid for sixty months. Authorization to Construct is valid for a period equal to that of Improvement Permit – not to exceed sixty months.

Signed: date 6/28/05 Installed by: Myers Septic

Improvement Permit by: RS date 6/21/05 Operation Permit by: Andy Melville date 9-8-05

Authorization to Construct by: RS date 6/21/05 Existing System Inspection by: date

HEALTH DEPT. COPY: WHITE OWNER COPY (FINAL): YELLOW OWNER COPY (INITIAL): PINK