IREDELL COUNTY HEALTH DEPARTMENT

STATESVILLE 704-878-5305 50.00 Paid MOORESVILLE 704-664-5281

IMPROVEMENT PERMIT / AUTHORIZATION TO CONSTRUCT / OPERATION PERMIT / EXISTING SYSTEM INSPECTION

PERMIT# 118542 PIN# ~~4656-18-2595~~ 4656183533 DATE 1/22/04

OWNER OR CONTRACTOR First Church of the Nazarene PHONE: Business 664-4761 Home

ADDRESS 2940 Charlotte Hwy. Mooresville, NC. 28117

LOCATION 21 S on (R) below Brawley School Rd.

SUBDIVISION NA BLOCK / SECTION LOT LOT AREA ~ 7AC SITE CLASS. RS DESIGN FLOW 600GPD. L.T.A.R. .3

Septic Tank: EXIST 1200 Gallons; STB Date

Pump Tank: EXIST. 1000 Gallons; PT Date

Pump Make: Model Serial No.

Nitrification Field: No Fields Square Feet 2000 Linear Feet 666

No Lines 6 Trench Width 3 Max Trench Bottom Depth 32-36" Gravel Depth 12"

☐ New System ☐ Repair System Type: I, II, (III), IV, V, VI

System Description: EXISTING SYSTEM

Repair System Description:

Maintenance Agreement Required: ☐ Yes ☒ No

☐ House/Mod. Home No. Bedrooms

☐ Mobile Home No. Bathrooms

☐ Business No. Employees

☒ Other Church - 200 seat (E) 3gpf

☐ Slab ☐ Crawl Space ☐ Basement w/plumbing ☐ Basement wo/plumbing


Water Supply: ☒ Individual ☐ Public ☐ Community

Comments:/Conditions:

3@ 111' X 3'


REPAIR

INITIAL SITE SKETCH

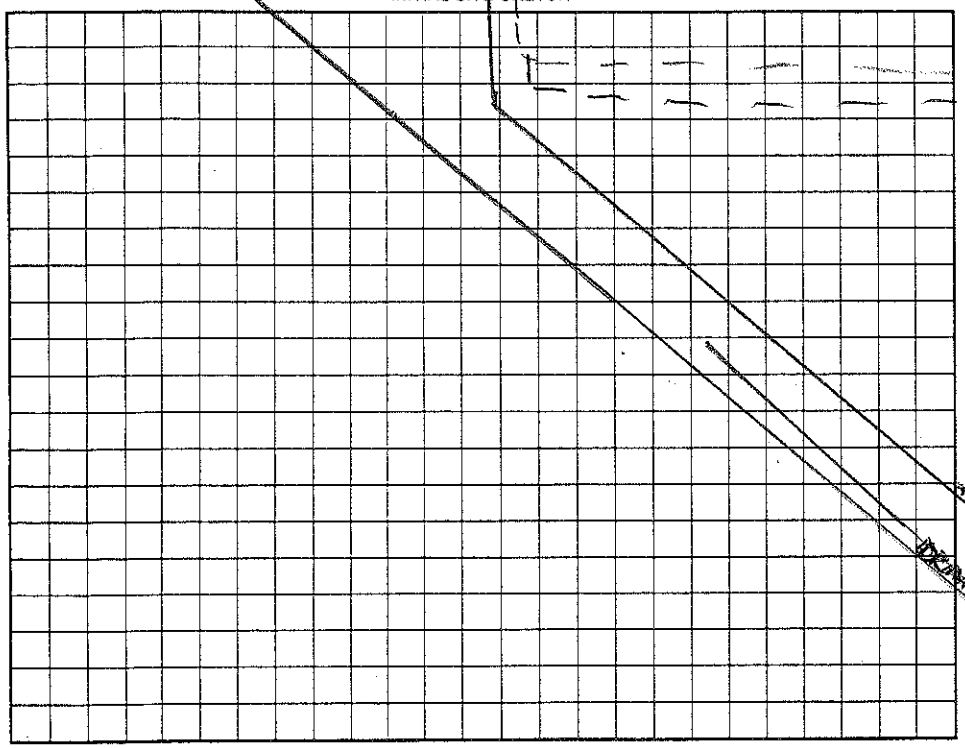

Comments:/Conditions:

AS BUILT SKETCH

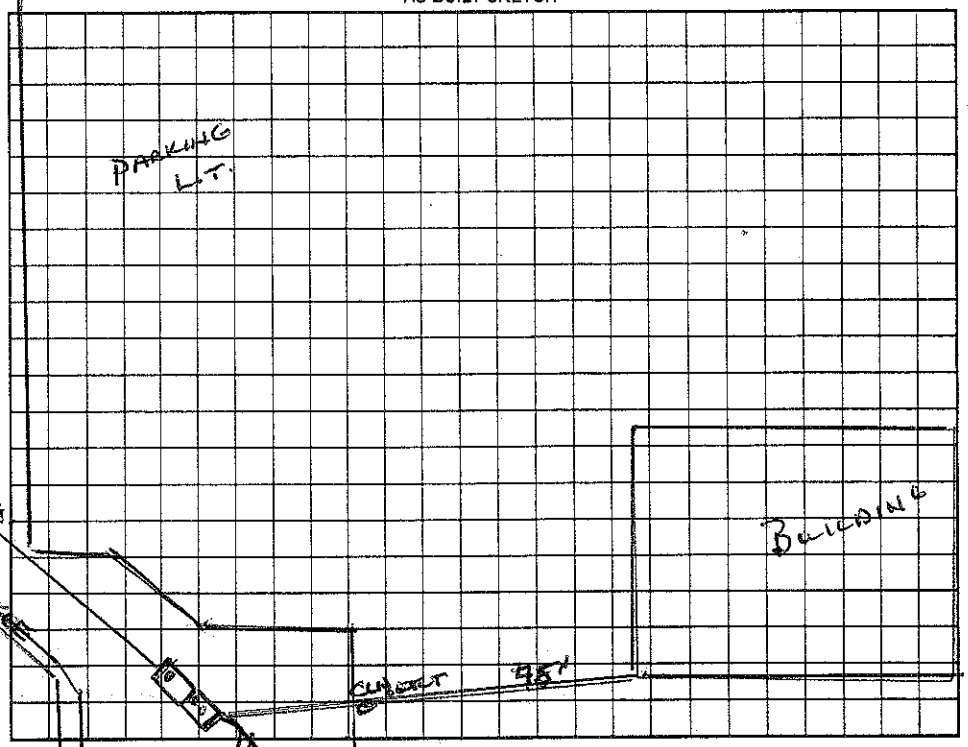

Permit can be suspended or revoked if any false information is supplied toward securing the permit/any unauthorized changes are made to the site/any unauthorized changes are made in the installation of the system. Improvement Permit with plat/valid without expiration. Improvement Permit with site plan valid for sixty months. Authorization to Construct is valid for a period equal to that of Improvement Permit – not to exceed sixty months.

Signed: date 2/6/04

Improvement Permit by: date

Authorization to Construct by: date

Installed by:

Operation Permit by: date

Existing System Inspection by: Wesley Parker RS. date 1/29/04

DRIVE

HEALTH DEPT. COPY: WHITE OWNER COPY (FINAL): YELLOW OWNER COPY (INITIAL): PINK