LDS

4656194043

IREDELL COUNTY HEALTH DEPARTMENT

STATESVILLE 704-878-5305 MOORESVILLE 704-664-5281

IMPROVEMENT PERMIT / CERTIFICATE OF COMPLETION / OPERATION PERMIT / EXISTING SYSTEM INSPECTION

PROPERTY DESCRIPTION NO. 4006 DATE 8/7/96 TAX MAP NO. 1K A 60 Watershed: ☐ Yes ☐ No

OWNER OR CONTRACTOR CHURCH OF JESUS CHRIST OF LATTER DAY SAINTS PHONE: Business Home

ADDRESS LAZY LANE

LOCATION 21 - TR BRAWLEY SCHOOL RD - TL LAZY LANE - AT END OF RD.

SUBDIVISION — BLOCK / SECTION — LOT LOT AREA SITE CLASS. PS DESIGN FLOW 1250 gpd L.T.A.R. exempt

Septic Tank: Existing Gallons; STB Date

Pump Tank: Existing Gallons; PT Date

Pump Make: Model Serial No.

Nitrification Field: No Fields — Square Feet 3300 Linear Feet 1100

No Lines 11 Trench Width 36" Max Trench Bottom Depth — Gravel Depth 12"

☑ New System ☐ Repair System Type: I, II, III, IV, V, VI

System Description: Pump Conventional

Repair System Description:

Maintenance Agreement Required: ☐ Yes ☑ No

☐ House/Mod. Home No. Bedrooms

☐ Mobile Home No. Bathrooms

☐ Business ~~No. Employees~~ SEATS 250

☑ Other Church


☑ Slab ☐ Crawl Space ☐ Basement w/plumbing ☐ Basement wo/plumbing

Water Supply: ☑ Individual ☐ Community ☐ Public


Comments:

Comments: 250 SEATS (5gpd/seat) Design Flow = 1250.

INITIAL SITE SKETCH

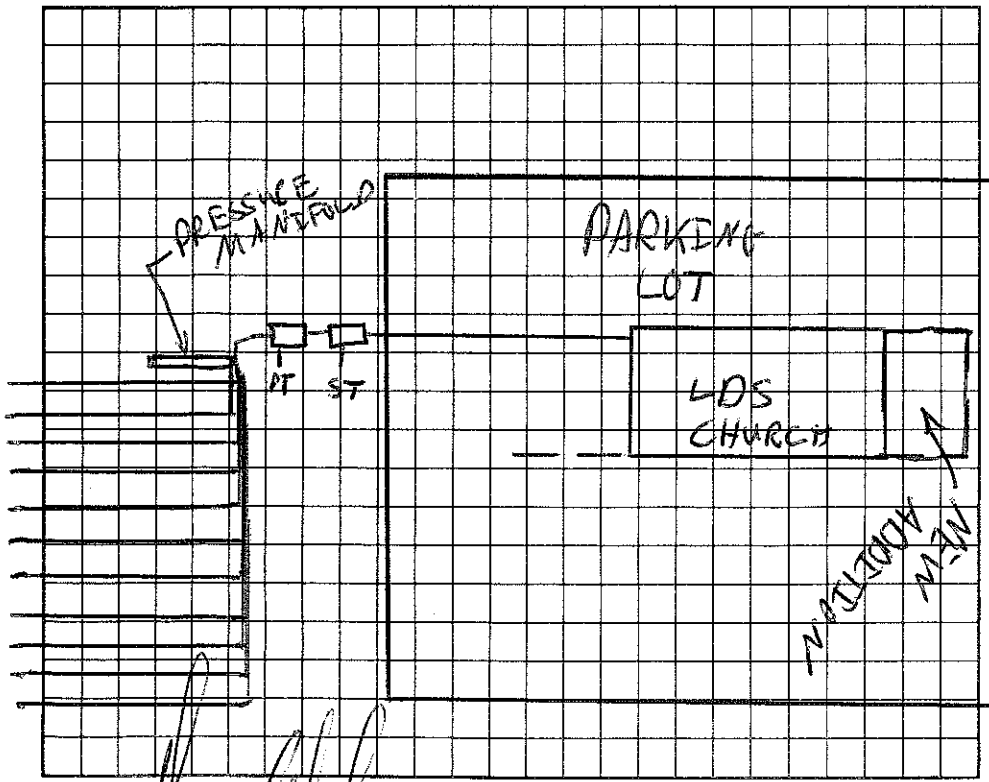

AS BUILT SKETCH

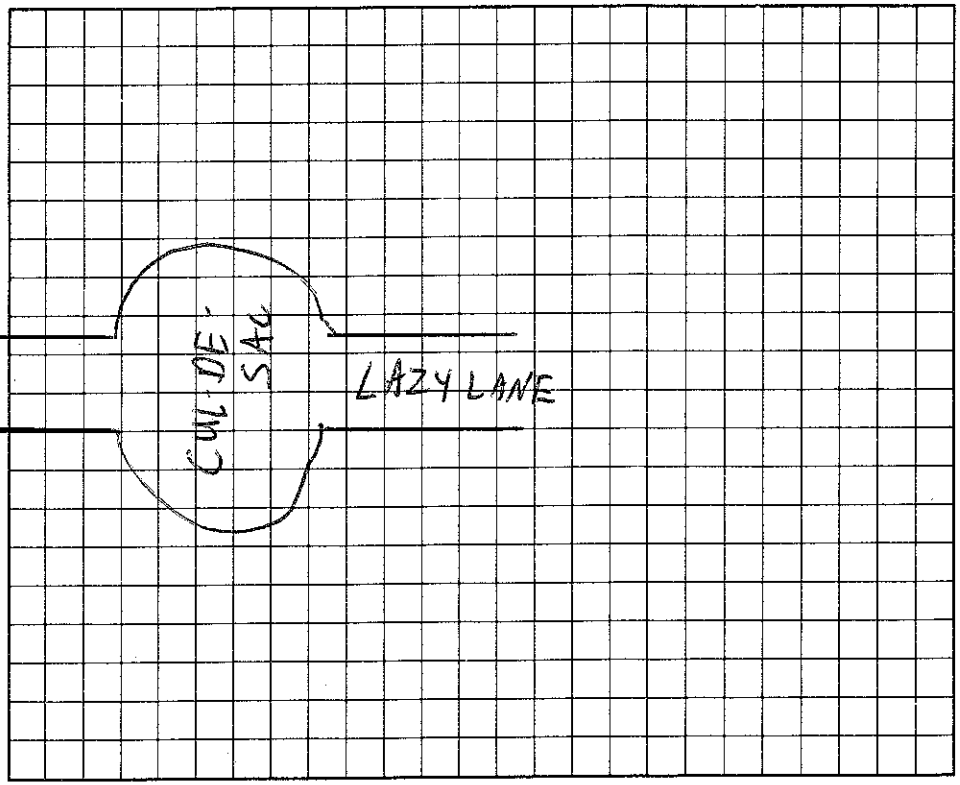

I understand that this permit can be suspended or revoked if any false information is supplied toward securing the permit/any unauthorized changes are made to the site/any unauthorized changes are made in the installation of the system.

Signed:

Installed by: SAMMY REAVES - March 12 / 1990

Improvement Permit by: date

Certificate of Completion by: date

Existing System Inspection by: C. B. Thomason EHS date 8/7/96

Operation Permit by: C. B. Thomason EHS date 8/7/96

HEALTH DEPT. COPY: WHITE INSPECTION COPY (FINAL): GREEN OWNER COPY (FINAL): YELLOW INSPECTION COPY (INITIAL): PINK OWNER COPY (INITIAL): GOLD