IREDELL COUNTY HEALTH DEPARTMENT

Statesville Office (704) 878-5305 Mooresville Office (704) 660-3625 PERMIT #

IMPROVEMENT PERMIT / AUTHORIZATION TO CONSTRUCT / OPERATION PERMIT / EXISTING SYSTEM

PIN # 4656260474

APPLICANT: Jeff Barlase/Aloha Pools APPLICANT ADDRESS: 169 Deerwood Ln

SITE ADDRESS: 169 Deerwood Ln. Mooresville, NC 28117 PHONE: ALT. PHONE:

SITE DIRECTIONS: US 21 South TL Deerwood (Before Waterlynn)

SUBDIVISION: Deerwood SECTION: LOT # LOT AREA: ~6 acres DESIGN FLOW: 360gpd L.T.A.R.:


Septic Tank	1250	(gal)	STB	Date	☐ New System ☐ Repair ☐ Expansion	System Type: ☐ I ☐ II ☐ III ☐ IV ☐ V ☐ VI	☒ Residence	No. Bedrooms	3	Water Supply	
Pump Tank		(gal)	PT	Date	System Description: Existing Gravity-Conventional Bed		☐ Business	No. Persons		☒ Private	
Pump Make		Model		Serial #	Repair System Description:		☐ Other	No. Employees		☐ Public	
# Nitrification Fields	1	# Lines	3	Linear Ft: 270'	Maintenance Agreement Required:	☐ YES ☒ NO	☐ Slab	☐ Crawl Space		☐ Community	
Trench Width	7½ ft	Max. Trench Bottom Depth		Gravel Depth 12"–15"	☒ GRAVITY	☐ PRESSURE	☐ Basement w/ plumbing			☐ Basement w/o plumbing	

Exist


Comments / Conditions:

Existing System appears to be functioning okay at time of inspection.

INITIAL SITE SKETCH

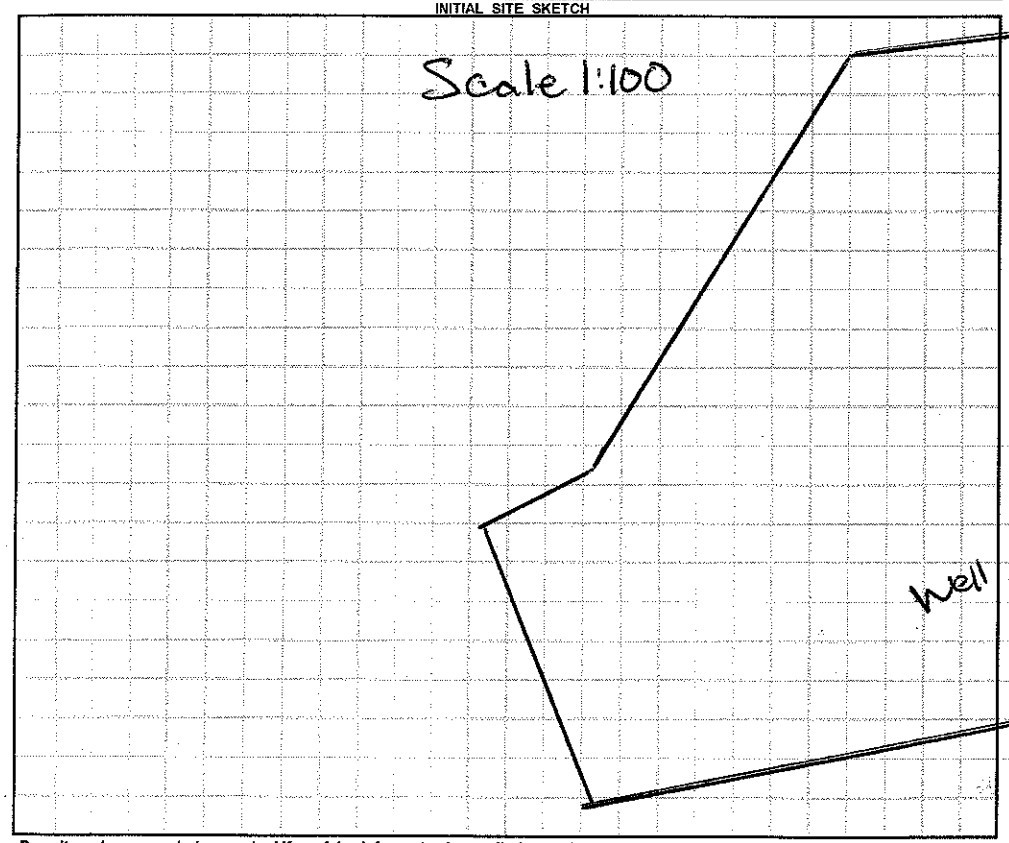

AS BUILT SKETCH

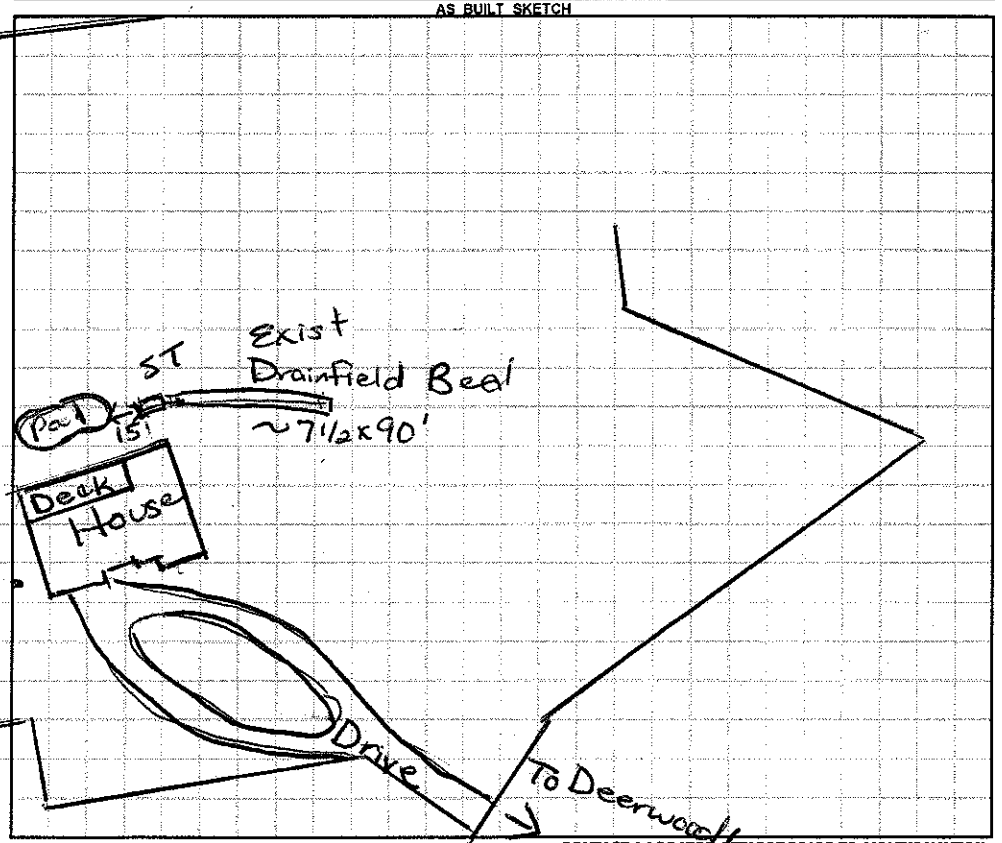

Permit can be suspended or revoked if any false information is supplied toward securing the permit / any unauthorized changes are made to the site / any unauthorized changes are made in the installation of the system. **CONTACT A LOCATOR SERVICE PRIOR TO ANY EXCAVATION**

☐ **IMPROVEMENT PERMIT** ***with plat*** *valid without expiration.* ☐ **IMPROVEMENT PERMIT** ***with site plan*** *valid for 60 mos.* o exceed 60 mo.

Owner / Applicant Signature: Date: Installed b

IMPROVEMENT PERMIT by: Date: OPERATIOI

AUTHORIZATION TO CONSTRUCT by: Date: Existing S)

Location of the proposed Inground Swimming Pool addition does not appear to impact the existing on-site septic system.**NOTE: Must keep Pool Cut at least 15ft from Septic

Marian H. Dotson REHS

Date: 4/12/13

ICHD-Environmental Health Division

Health Dept. Copy - WHITE Applicant (Final Approval) - YELLOW