IREDELL COUNTY HEALTH DEPARTMENT

STATESVILLE 704-878-5305 MOORESVILLE 704-664-5281

IMPROVEMENT PERMIT / AUTHORIZATION TO CONSTRUCT / OPERATION PERMIT / EXISTING SYSTEM INSPECTION

PERMIT# 6216 PIN# 4656 32 9965 DATE 1/14/99

OWNER OR CONTRACTOR Billy H. Miller PHONE: Business _____ Home 663-4305

ADDRESS 146 Mackwood Rd. Mooresville, NC. 28115

LOCATION Almond Rd, 1155 ft Mackwood TR Almond Rd to #120 on (R)

SUBDIVISION No BLOCK / SECTION _____ LOT _____ LOT AREA .95 SITE CLASS. _____ DESIGN FLOW 360 L.T.A.R. _____

Septic Tank: EXISTING 1000 Gallons; STB _____ Date _____

Pump Tank: _____ Gallons; PT _____ Date _____

Pump Make: _____ Model _____ Serial No. _____

Nitrification Field: No Fields ____ Square Feet 900 Linear Feet 300

No Lines 3 Trench Width 36" Max Trench Bottom Depth — Gravel Depth 12"

☐ New System ☐ Repair System Type: I (II) III, IV, V, VI

System Description: Existing System

Repair System Description: _____

Maintenance Agreement Required: ☐ Yes ☐ No

☐ House/Mod. Home No. Bedrooms 3

☑ Mobile Home No. Bathrooms 2

☐ Business No. Employees ____

☐ Other _____

☐ Slab ☐ Crawl Space ☐ Basement w/plumbing ☐ Basement wo/plumbing


Water Supply:
☒ Individual
☐ Public
☐ Community

Comments:/Conditions:

Comments:/Conditions:

INITIAL SITE SKETCH

AS BUILT SKETCH

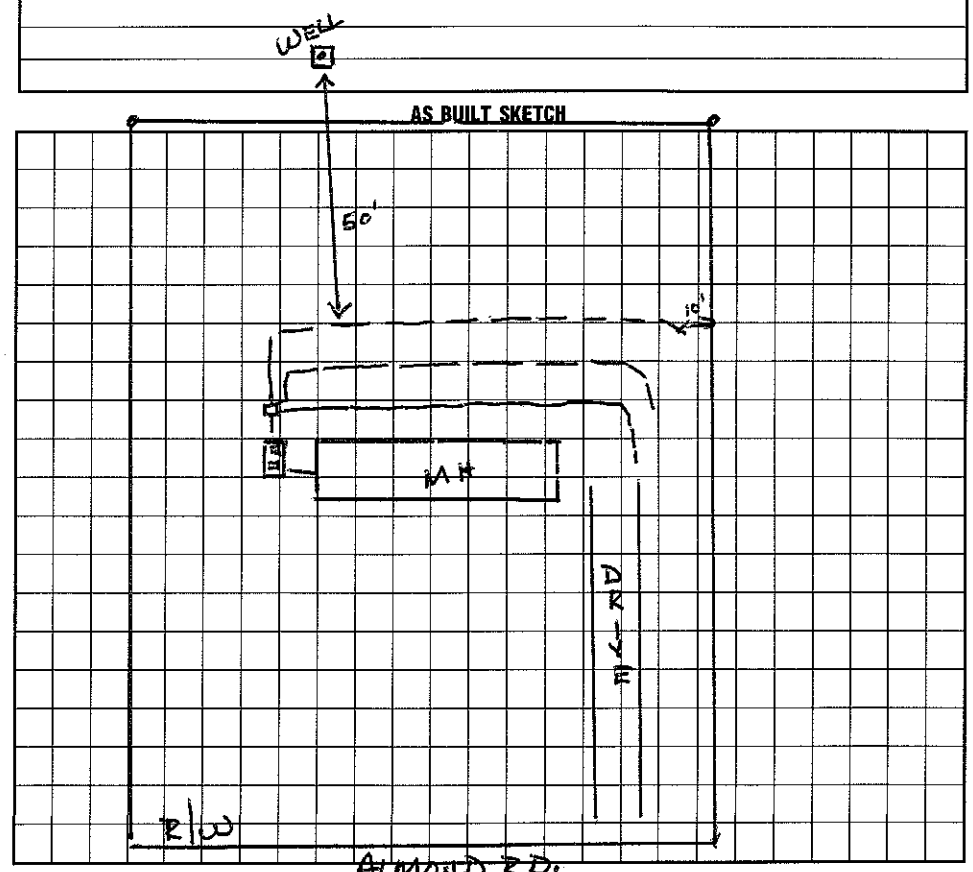

I understand that this permit can be suspended or revoked if any false information is supplied toward securing the permit/any unauthorized changes are made to the site/any unauthorized changes are made in the installation of the system. Improvement Permit with plat valid without expiration. Improvement Permit with site plan valid for sixty months. Authorization to Construct is valid for a period equal to that of Improvement Permit – not to exceed sixty months.

Signed: _____ date _____

Improvement Permit by: _____ date _____

Authorization to Construct by: _____ date _____

Installed by: F J Erwin

Operation Permit by: Wesley Sparks RS. date 1/14/99

Existing System Inspection by: _____ date _____

HEALTH DEPT. COPY: WHITE INSPECTION COPY (FINAL): GREEN OWNER COPY (FINAL): YELLOW INSPECTION COPY (INITIAL): PINK OWNER COPY (INITIAL): GOLD