IREDELL COUNTY HEALTH DEPARTMENT

STATESVILLE 704-878-5305 MOORESVILLE 704-664-5281

IMPROVEMENT PERMIT / CERTIFICATE OF COMPLETION / OPERATION PERMIT / EXISTING SYSTEM INSPECTION

PROPERTY DESCRIPTION NO. 2326 DATE 6/15/93 TAX MAP NO. 10 1B 41

OWNER OR CONTRACTOR BILLY MILLER PHONE: Business _____ Home 663-4305

ADDRESS Rt 11 Box 115 MOORESVILLE, NC.

LOCATION ALMOND RD TR OFF MACKWOOD RD. TO 3+4th LOTS ON R

SUBDIVISION N/A BLOCK / SECTION _____ LOT _____ LOT AREA _____ SITE CLASS. P L.T.A.R. .3

Water Supply: ☑ Individual ☐ Community ☐ Public

Septic Tank: 1000 Gallons; STB 782 Date 5-4-93

Pump Tank: _____ Gallons; PT _____ Date _____

Nitrification Field: No Fields 1 Square Feet ~~900~~ 300 Linear Feet ~~345~~

No Lines 3 Trench Width 3' Trench Depth 28" Gravel Depth 12"

☑ New System ☐ Repair System Type: I, II, ⓘ IV, V, VI

System Description: WELL ⓘ CONV.

Repair System Description: CONV.

Maintenance Agreement Required: ☐ Yes ☑ No

☐ House/Mod. Home ☑ Mobile Home ☐ Business ☐ Other

No. Bedrooms 3 No. Bathrooms 2 No. Employees _____

☐ Slab ☑ Crawl Space ☐ Basement w/plumbing ☐ Basement wo/plumbing

Garbage Disposal: ☐ Yes ☑ No

Auto. Dishwasher: ☑ Yes ☐ No


Auto. Washing Machine: ☑ Yes ☐ No

Other _____


Comments — THIS VOIDS PERMIT DATED 6/3/93 —

Mobile not set up at time of septic ~~permit~~ Completion. Water line ~~not~~ Bored not installed. ⊗ Ex Well

INITIAL SITE SKETCH

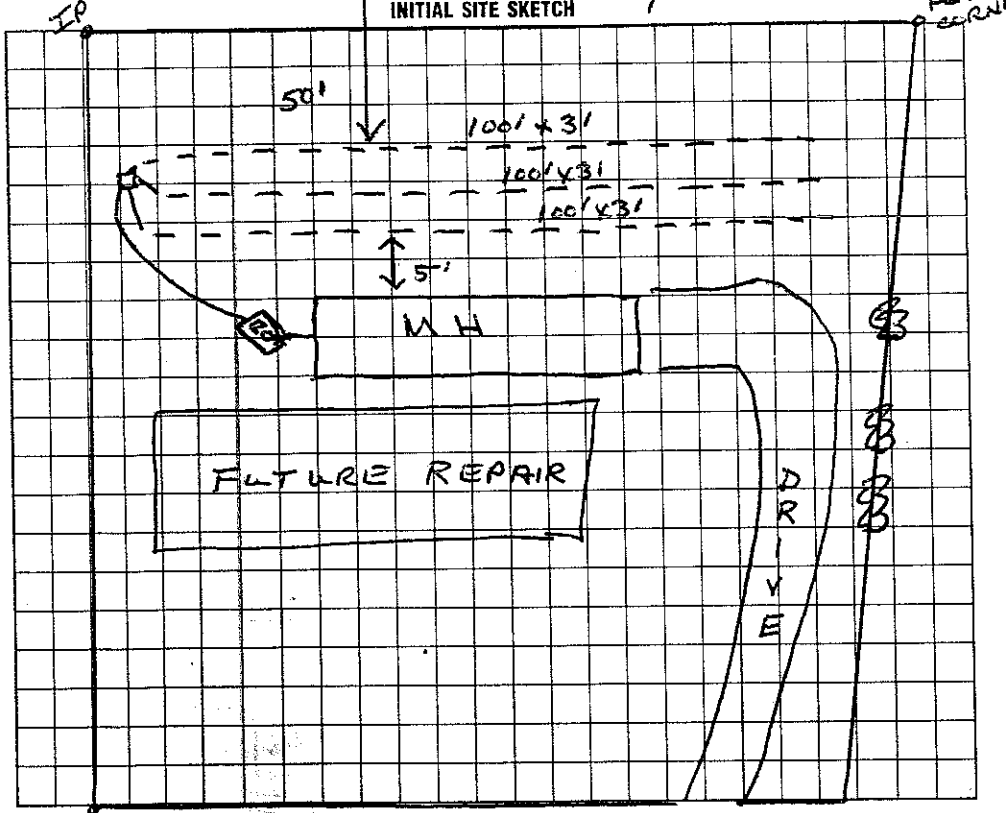

AS BUILT SKETCH

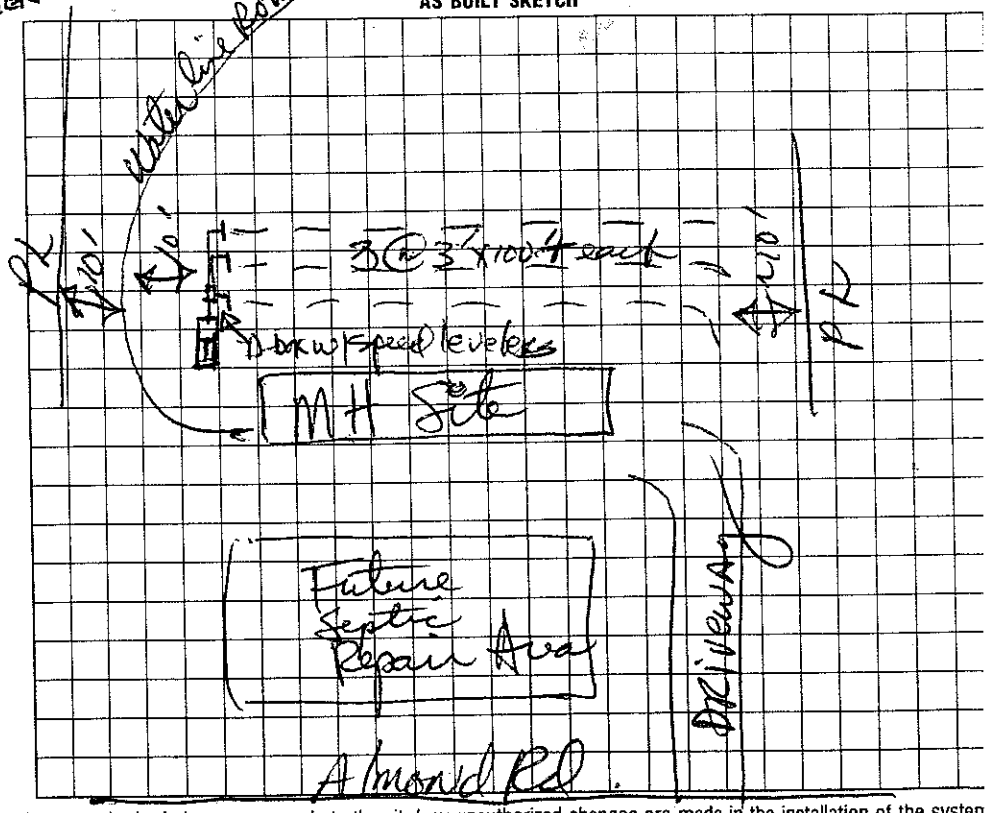

I understand that this permit can be suspended or revoked if any false information is supplied toward securing the permit/any unauthorized changes are made to the site/any unauthorized changes are made in the installation of the system
Improvement Permit is valid for 60 months from date of issuance. ALMOND RD.

Signed: X Billy H. Miller

Improvement Permit by Wesley Sparks RS. date 6/15/93

Existing System Inspection by: _____ date _____

Installed by: T. J. Cannon Const.

Certificate of Completion by: Dave Harmon date 7/7/93

Operation Permit by: _____ date _____

HEALTH DEPT. COPY: WHITE INSPECTION COPY (FINAL): GREEN OWNER COPY (FINAL): YELLOW INSPECTION COPY (INITIAL): PINK OWNER COPY (INITIAL): GOLD