4056345519

IREDELL COUNTY HEALTH DEPARTMENT

STATESVILLE 704-878-5305 MOORESVILLE 704-664-5281

330

IMPROVEMENT PERMIT / CERTIFICATE OF COMPLETION / OPERATION PERMIT / EXISTING SYSTEM INSPECTION

PROPERTY DESCRIPTION NO. Existing/Repair DATE 7/24/97 TAX MAP NO. Existing/Repair Watershed: ☐ Yes ☐ No

OWNER OR CONTRACTOR Tom Mellon PHONE: Business 1-800 930-8499 Home 662-332-9

ADDRESS 164 Foursquare Mooresville NC 28115

LOCATION 115 S to Foursquare TR ≈ 1 Blk

SUBDIVISION _____ BLOCK / SECTION _____ LOT _____ LOT AREA _____ SITE CLASS. PS DESIGN FLOW Repair L.T.A.R. .3

Septic Tank Existing Gallons; STB _____ Date _____

Pump Tank: _____ Gallons; PT _____ Date _____

Pump Make: _____ Model _____ Serial No. _____

Nitrification Field: No Fields 1 Square Feet 375' Linear Feet 125'

No Lines 5' at 25' Trench Width 15' Max Trench Bottom Depth 48" Gravel Depth N/A

☐ New System ☒ Repair System Type: I, II, ☒ III, IV, V, VI

System Description: _____

Repair System Description: Bed 25'x15' - Plastic Chamber

Maintenance Agreement Required: ☐ Yes ☒ No

☒ House/Mod. Home No. Bedrooms 2

☐ Mobile Home No. Bathrooms 1

☐ Business No. Employees _____

☐ Other _____


☐ Slab ☒ Crawl Space ☐ Basement w/plumbing ☐ Basement wo/plumbing

Water Supply: ☒ Individual ☐ Community ☐ Public


Comments: Keep Septic system at least 50' From any well & 5' From property lines & 5' from house. (Depth - 48" w/ 1 Foot of sand)

Comments:

INITIAL SITE SKETCH Not to Scale

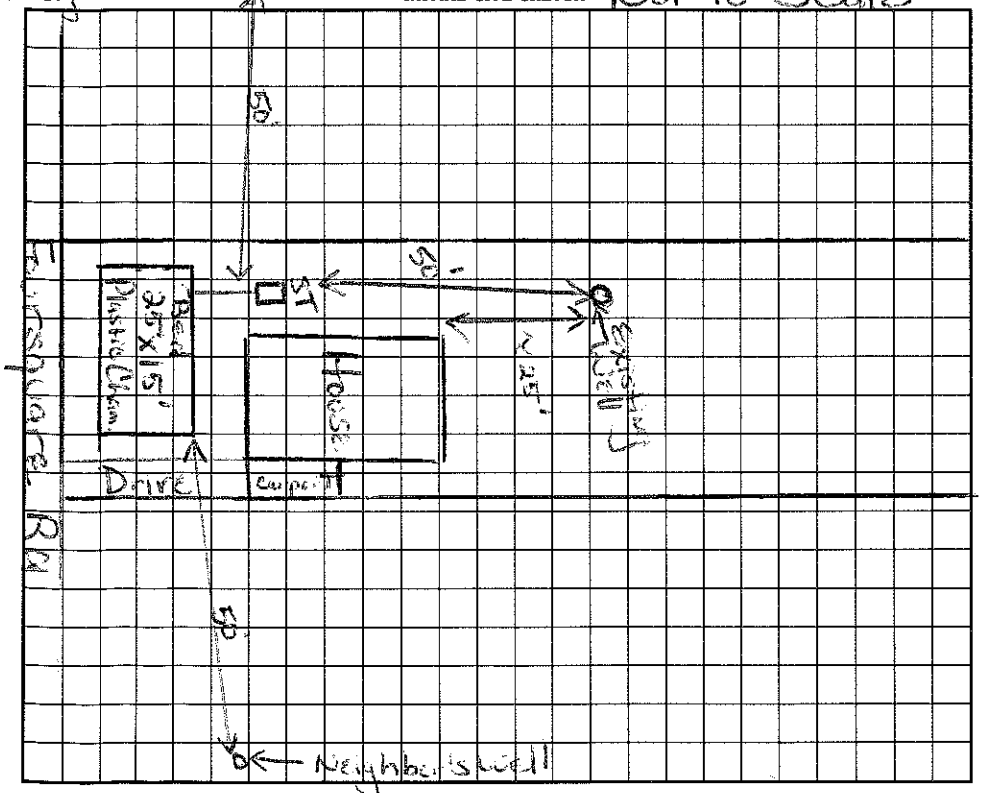

AS BUILT SKETCH

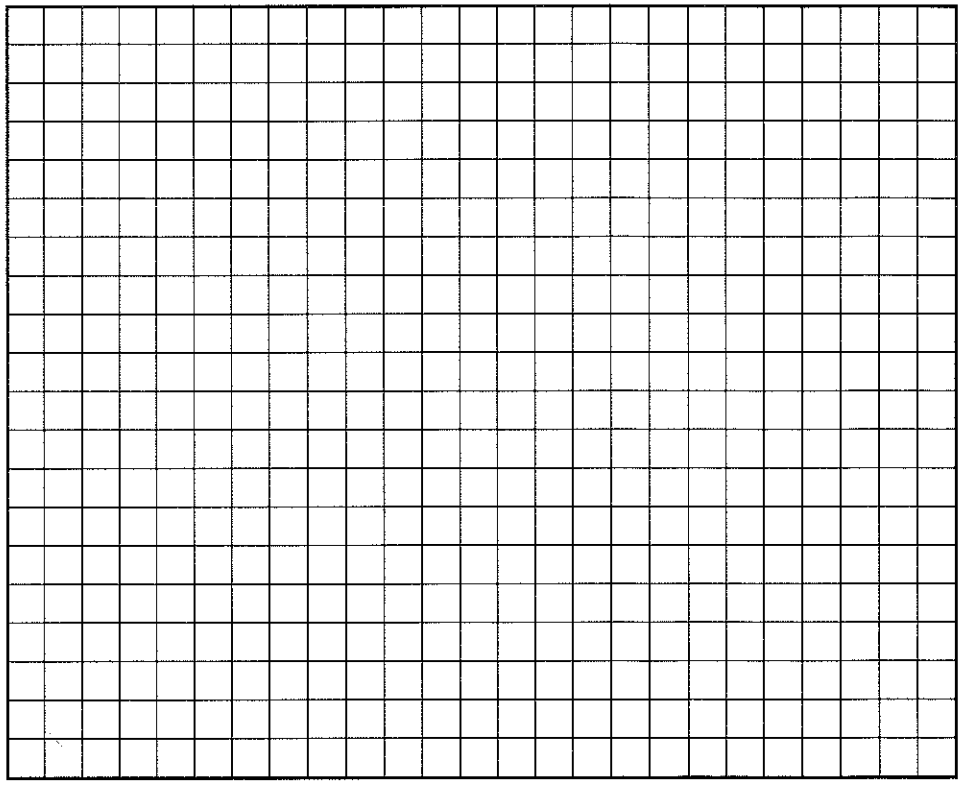

I understand that this permit can be suspended or revoked if any false information is supplied toward securing the permit/any unauthorized changes are made to the site/any unauthorized changes are made in the installation of the system. Improvement Permit is valid for 60 months from date of issuance.

Signed: _____

Improvement Permit by: Marion H. H. Dotson date 7/24/97

Existing System Inspection by: Marion H. H. Dotson date 7/24/97

Installed by: Tim Ammons

Certificate of Completion by: Wesley Hanks RS. date 9/15/97

Operation Permit by: Wesley Hanks RS. date 9/15/97

Asphalt Const

HEALTH DEPT. COPY: WHITE INSPECTION COPY (FINAL): GREEN OWNER COPY (FINAL): YELLOW INSPECTION COPY (INITIAL): PINK OWNER COPY (INITIAL): GOLD