IREDELL COUNTY HEALTH DEPARTMENT

STATESVILLE 704-878-5305 MOORESVILLE 704-664-5281

IMPROVEMENT PERMIT / AUTHORIZATION TO CONSTRUCT / OPERATION PERMIT / EXISTING SYSTEM INSPECTION

PERMIT# N/A PIN# 4656 34 6539 DATE 1/30/04

OWNER OR CONTRACTOR Tom POTEAT PHONE: Business _____ Home 704-663-1992

ADDRESS 120 James Robert Ln. Mooresville, NC. 28115

LOCATION 158 Foursquare Rd.

SUBDIVISION No BLOCK / SECTION No LOT No LOT AREA EXISTING SITE CLASS. PS DESIGN FLOW 240 L.T.A.R. .3

Septic Tank: EXISTING Gallons; STB _____ Date _____

Pump Tank: _____ Gallons; PT _____ Date _____

Pump Make: _____ Model _____ Serial No. _____

Nitrification Field: No Fields 1 Square Feet 800 Linear Feet 300 ±

No Lines 4@75' Trench Width 3' Max Trench Bottom Depth 3' Gravel Depth N/A

☐ New System ☒ Repair System Type: I, II, III, IV, V, VI

System Description: _____

Repair System Description: GRAVITY - 25% Reduction

Maintenance Agreement Required: ☐ Yes ☒ No

☒ House/Mod. Home No. Bedrooms 2

☐ Mobile Home No. Bathrooms 1

☐ Business No. Employees _____


☐ Other _____

☐ Slab ☒ Crawl Space ☐ Basement w/plumbing ☐ Basement wo/plumbing

Water Supply: ☒ Individual ☐ Public ☐ Community

Comments:/Conditions:

INITIAL SITE SKETCH

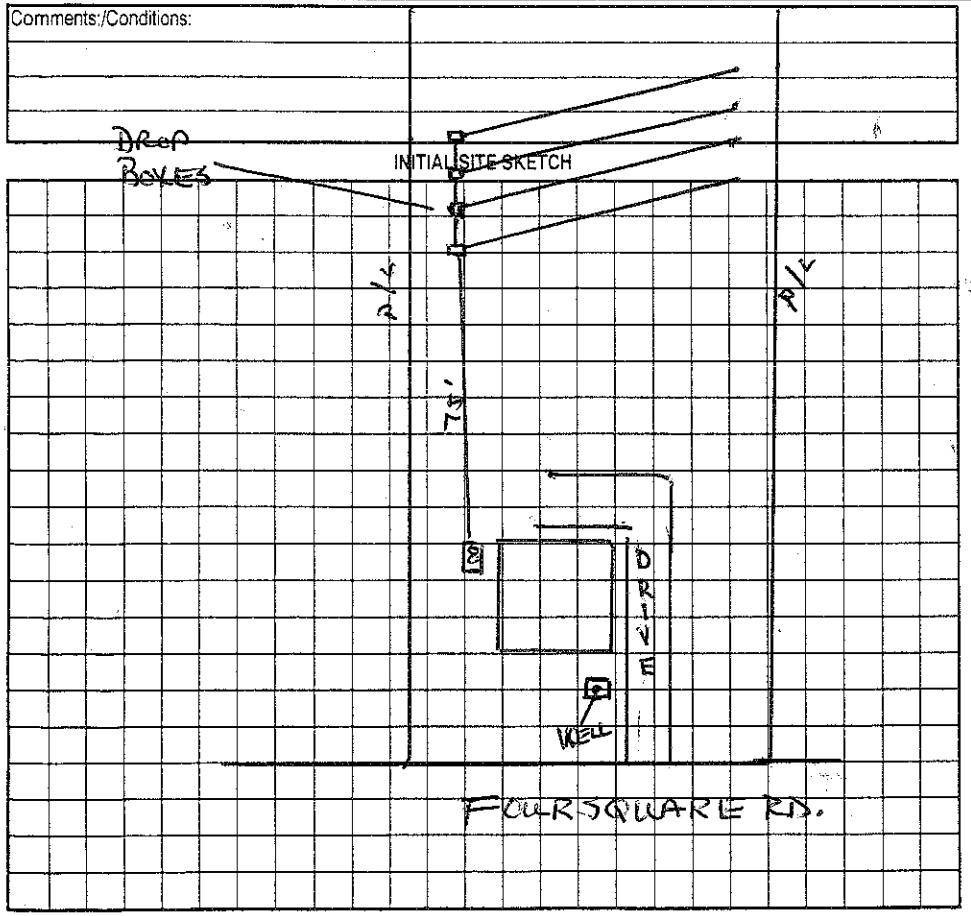

Comments:/Conditions: Infiltrator installed

AS BUILT SKETCH

Permit can be suspended or revoked if any false information is supplied toward securing the permit/any unauthorized changes are made to the site/any unauthorized changes are made in the installation of the system. Improvement Permit with plat valid without expiration. Improvement Permit with site plan valid for sixty months. Authorization to Construct is valid for a period equal to that of Improvement Permit – not to exceed sixty months.

Signed: ✕ Carolyn A. Poteat date 1-30-04

Improvement Permit by: Wesley Sparks RS. date 1/30/04

Authorization to Construct by: Wesley Sparks RS. date 1/30/04

Installed by: Ivan Burton

Operation Permit by: Wesley Sparks RS. date 3/18/04

Existing System Inspection by: _____ date _____

HEALTH DEPT. COPY: WHITE OWNER COPY (FINAL): YELLOW OWNER COPY (INITIAL): PINK