IREDELL COUNTY HEALTH DEPARTMENT

4656423324

STATESVILLE 704-878-5305 MOORESVILLE 704-664-5281

IMPROVEMENT PERMIT / CERTIFICATE OF COMPLETION / OPERATION PERMIT / EXISTING SYSTEM INSPECTION

PROPERTY DESCRIPTION NO. 3129 DATE 2/1/95 TAX MAP NO. 1D 1C 99A Watershed: ☐ Yes ☑ No

OWNER OR CONTRACTOR Rodney Van Zant PHONE: Business _____ Home 669-3578

ADDRESS Rt 11 Box 275 Mooresville, NC. 28115

LOCATION ~~Mackie~~ Market Rd TL just beyond New Life Church, to end of driveway on (R)

SUBDIVISION N/A BLOCK / SECTION _____ LOT _____ LOT AREA ~1.54c SITE CLASS P DESIGN FLOW 360 L.T.A.R. .3

Septic Tank: 1000 Gallons; STB _____ Date _____

Pump Tank: _____ Gallons; PT _____ Date _____

Pump Make: _____ Model _____ Serial No. _____

Nitrification Field: No Fields 1 Square Feet 190 Linear Feet 67

No Lines 1 Trench Width 3' Max Trench Bottom Depth 36" Gravel Depth _____

☑ New System ☐ Repair System Type: I, II, III, IV, V, VI

System Description: Repair

Repair System Description: _____

Maintenance Agreement Required: ☐ Yes ☑ No

☑ House/Mod. Home No. Bedrooms 3

☐ Mobile Home No. Bathrooms 2

☐ Business No. Employees _____

☐ Other _____


☐ Slab ☑ Crawl Space ☐ Basement w/plumbing ☐ Basement wo/plumbing

Water Supply: ☑ Individual ☐ Community ☐ Public

Comments: Septam upgrade up to 3BRm Home

Comments:

INITIAL SITE SKETCH

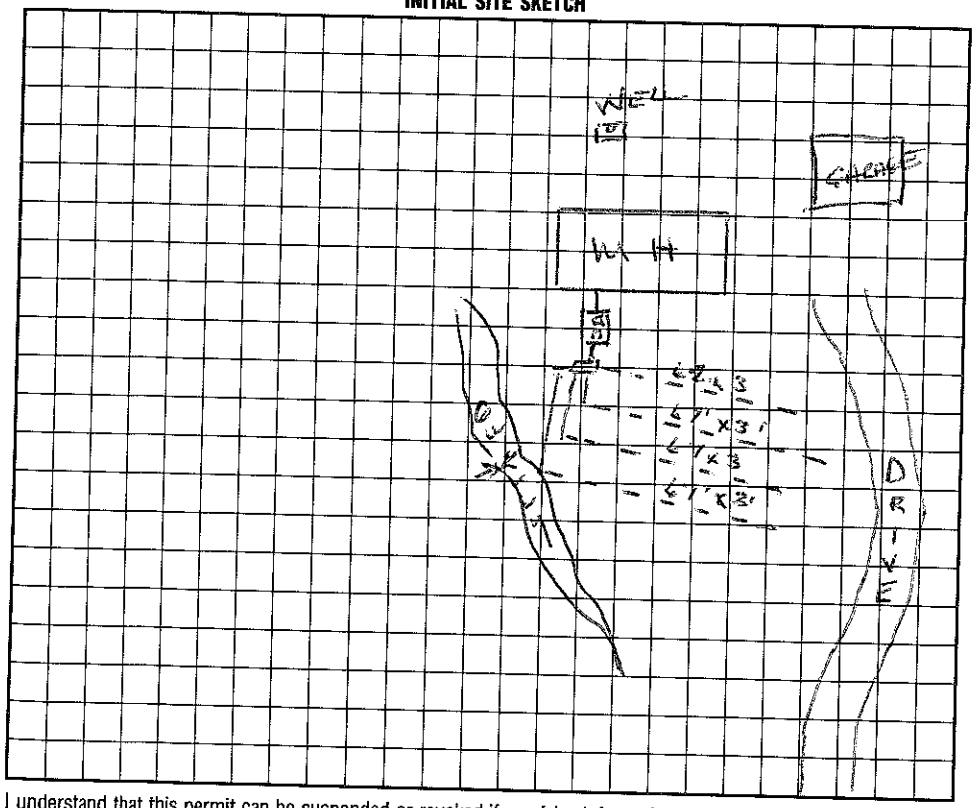

AS BUILT SKETCH

I understand that this permit can be suspended or revoked if any false information is supplied toward securing the permit/any unauthorized changes are made to the site/any unauthorized changes are made in the installation of the system. Improvement Permit is valid for 60 months from date of issuance.

Signed: Rodney Van Zant

Improvement Permit by: Wesley Sparks R.S. date 2/1/95

Existing System Inspection by: _____ date _____

Installed by: F J Ervin

Certificate of Completion by: Wesley Sparks R.S. date 2/13/95

Operation Permit by: _____ date _____

HEALTH DEPT. COPY: WHITE INSPECTION COPY (FINAL): GREEN OWNER COPY (FINAL): YELLOW INSPECTION COPY (INITIAL): PINK OWNER COPY (INITIAL): GOLD