4056430141

IREDELL COUNTY HEALTH DEPARTMENT

STATESVILLE 704-878-5305 MOORESVILLE 704-664-5281

IMPROVEMENT PERMIT / CERTIFICATE OF COMPLETION / OPERATION PERMIT / EXISTING SYSTEM INSPECTION

PROPERTY DESCRIPTION NO. 19583 DATE 10/20/94 TAX MAP NO. 10-1-B-38 Watershed: ☐ Yes ☒ No

OWNER OR CONTRACTOR Helen Woodfin PHONE: Business _____ Home 663-4424

ADDRESS 1175 Mecklenburg Hwy. Mooresville, NC. 28115

LOCATION 115 S. on L just past Blackwood Rd.

SUBDIVISION _____ BLOCK / SECTION _____ LOT 38, 39, 40 LOT AREA 17800 SITE CLASS. P DESIGN FLOW 240 L.T.A.R. .35

Septic Tank: 1000 Gallons; STB 794 Date 8/4/94

Pump Tank: _____ Gallons; PT _____ Date _____

Pump Make: _____ Model _____ Serial No. _____

Nitrification Field: No Fields 1 Square Feet 810 Linear Feet 270

No Lines 3 Trench Width 36" Max Trench Bottom Depth 36" Gravel Depth 12"

☐ New System ☐ Repair System Type: I (II) III, IV, V, VI

System Description: CONVENTIONAL

Repair System Description: _____

Maintenance Agreement Required: ☐ Yes ☒ No

☐ House/Mod. Home No. Bedrooms 2

☒ Mobile Home No. Bathrooms 1

☐ Business No. Employees _____

☐ Other _____


☐ Slab ☒ Crawl Space ☐ Basement w/plumbing ☐ Basement wo/plumbing

Water Supply: ☒ Individual ☐ Community ☐ Public

Comments: Very tight on space
No room for correction.

Comments: installed expertly as shown on Improvement Permit

INITIAL SITE SKETCH

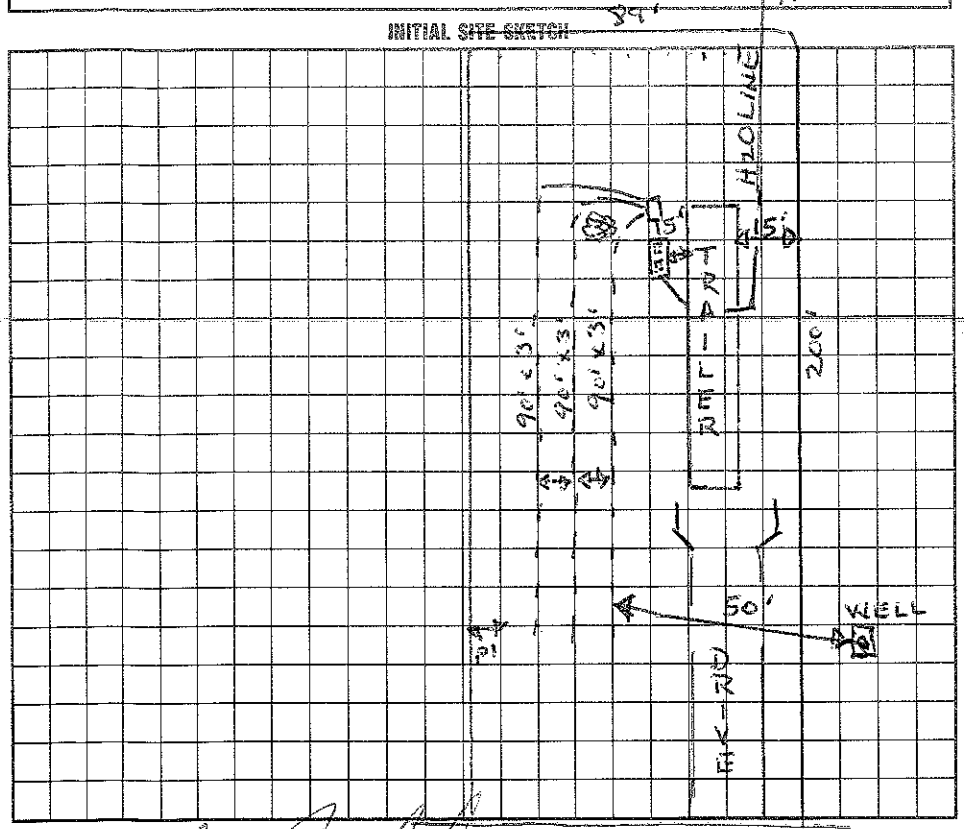

AS BUILT SKETCH

I understand that this permit can be suspended or revoked if any false information is supplied toward securing the permit/any unauthorized changes are made to the site/any unauthorized changes are made in the installation of the system. Improvement Permit is valid for 60 months from date of issuance. ALMOND RD.

Signed: _____

Improvement Permit by: Wesley Sparks R.S. date 10/20/94

Existing System Inspection by: _____ date _____

Installed by: Todd Wright

Certificate of Completion by: Wesley Sparks R.S. date 10/24/94

Operation Permit by: _____ date _____

HEALTH DEPT. COPY: WHITE INSPECTION COPY (FINAL): GREEN OWNER COPY (FINAL): YELLOW INSPECTION COPY (INITIAL): PINK OWNER COPY (INITIAL): GOLD