IREDELL COUNTY HEALTH DEPARTMENT

STATESVILLE 704-878-5305 MOORESVILLE 704-664-5281

IMPROVEMENT PERMIT / AUTHORIZATION TO CONSTRUCT / OPERATION PERMIT / EXISTING SYSTEM INSPECTION

PERMIT# 6925 PIN# 4656433926 DATE 8-13-99

OWNER OR CONTRACTOR Abundant Life Christian Center PHONE: Business 663-1523 Home 664-5650 - John Murray

ADDRESS 119 Foursquare Rd. Mooresville NC

LOCATION Hwy 115 S. TR Foursquare Rd over R.R. tracks on left

SUBDIVISION _____ BLOCK / SECTION _____ LOT _____ LOT AREA _____ SITE CLASS. PS DESIGN FLOW 450gpd L.T.A.R. .3+

Septic Tank: 1000 Gallons; STB 312 Date 5/25/99
Pump Tank: _____ Gallons; PT _____ Date _____
Pump Make: _____ Model _____ Serial No. _____
Nitrification Field: No Fields 1 Square Feet 1200' Linear Feet 400'
No Lines 4 at 100' Trench Width 36" Max Trench Bottom Depth 36"

X New System ☐ Repair System Type: I, II, III, IV, V, VI
System Description: Gravity - 25% Reduction / Innovative
Repair System Description: Gravity - Paved Block
Maintenance Agreement Required: ☐ Yes X No
Gravel Depth N/A ☐ Slab X Crawl Space ☐ Basement w/plumbing ☐ Basement wo/plumbing


☐ House/Mod. Home No. Bedrooms ---
☐ Mobile Home No. Bathrooms ---
X Business Church No. ~~Employees~~ 45
X Other School Students

Water Supply: X Individual (Shared Well) ☐ Public ☐ Community

Comments/Conditions: Abandon old Septic tank per Building Inspections requirements. Abandon Well (B) per NCDHHER requirements, hook up to Well (A) For water supply. Install 4-100' or 5-80' lines.

Comments/Conditions: Keep Septic System at least 10' from PL & 5' From House, 100' from water supply well & 50' from Neighbor's well. System sized for 45 people. Tanks liner checked

INITIAL SITE SKETCH NOT TO Scale

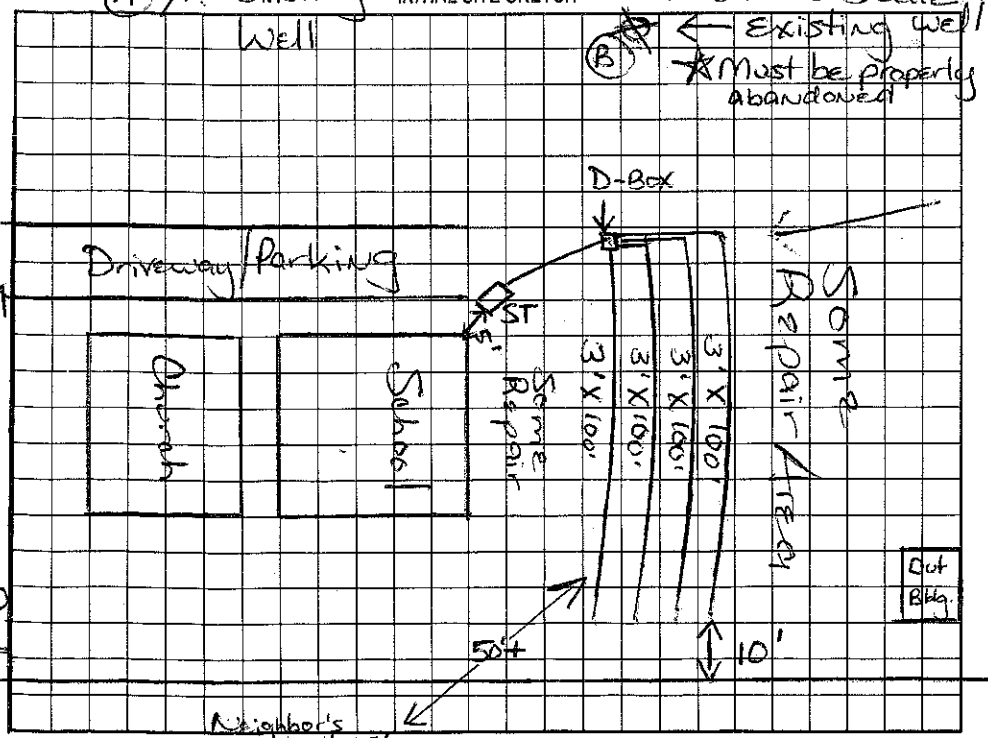

AS BUILT SKETCH 8/24/99 mE - Waiting for well to be drilled.

9/3/99 Per Well Drilling Co. there's greater than 18" between waterline & Septic System.

Permit can be suspended or revoked if any false information is supplied toward securing the permit/any unauthorized changes are made to the site/any unauthorized changes are made in the installation of the system. Improvement Permit with plat valid without expiration. Improvement Permit with site plan valid for sixty months. Authorization to Construct is valid for a period equal to that of Improvement Permit – not to exceed sixty months.

Signed: _____ 8/13/99 date _____ Installed by: E.J. Ervin

Improvement Permit by: Maria H. Dotson RS. date 8/13/99 Operation Permit by: Maria H. Dotson RS date 9/3/99

Authorization to Construct by: Maria H. Dotson RS. date 8/13/99 Existing System Inspection by: _____ date _____

HEALTH DEPT. COPY: WHITE OWNER COPY (FINAL): YELLOW OWNER COPY (INITIAL): PINK