# IREDELL COUNTY HEALTH DEPARTMENT

STATESVILLE 704-878-5305 MOORESVILLE 704-664-5281

## IMPROVEMENT PERMIT / AUTHORIZATION TO CONSTRUCT / OPERATION PERMIT / EXISTING SYSTEM INSPECTION

PERMIT# 5250 PIN# 4656434814

OWNER OR CONTRACTOR International Church of Foursquare Gospel PHONE: Business _____ DATE 12/18/97

ADDRESS 119 Foursquare Rd. Mooresville NC. 28115 Home 663-3697

LOCATION 1155 - TR Foursquare Rd. TL Keller Ridge Rd. # 112 2nd on (R)

SUBDIVISION N/A BLOCK / SECTION _____ LOT _____ LOT AREA Existing SITE CLASS. _____ DESIGN FLOW 360 L.T.A.R. _____

Septic Tank: EXISTING Gallons; STB _____ Date _____

Pump Tank: _____ Gallons; PT _____ Date _____

Pump Make: _____ Model _____ Serial No. _____

Nitrification Field: No Fields 1 Square Feet 1000 Linear Feet 300

No Lines 3 Trench Width 10' Max Trench Bottom Depth 39" Gravel Depth 12-14"

☐ New System ☐ Repair System Type: I (II) III, IV, V, VI

System Description: Existing System

Repair System Description: _____

Maintenance Agreement Required: ☐ Yes ☐ No

☐ Slab ☐ Crawl Space ☐ Basement w/plumbing ☐ Basement wo/plumbing

☒ House/Mod. Home No. Bedrooms 3

☐ Mobile Home No. Bathrooms 2

☐ Business No. Employees ____

☐ Other _____


Water Supply: ☒ Individual ☐ Public ☐ Community

Comments:/Conditions:

Comments:/Conditions:

INITIAL SITE SKETCH

AS BUILT SKETCH

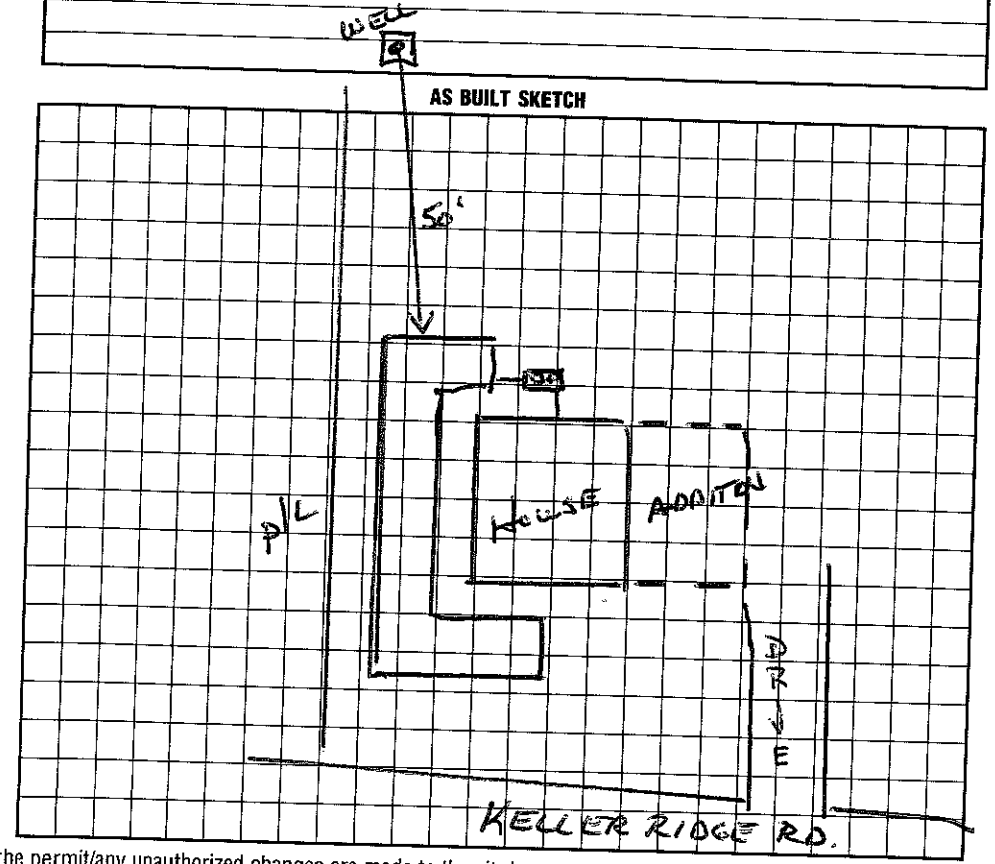


I understand that this permit can be suspended or revoked if any false information is supplied toward securing the permit/any unauthorized changes are made to the site/any unauthorized changes are made in the installation of the system. Improvement Permit with plat valid without expiration. Improvement Permit with site plan valid for sixty months. Authorization to Construct is valid for a period equal to that of Improvement Permit – not to exceed sixty months.

Signed: _____ date _____ Installed by: _____

Improvement Permit by: _____ date _____ Operation Permit by: Wesley Sparks RS date 12/18/97

Authorization to Construct by: _____ date _____ Existing System Inspection by: Wesley Sparks RS. date 12/18/97

HEALTH DEPT. COPY: WHITE INSPECTION COPY (FINAL): GREEN OWNER COPY (FINAL): YELLOW INSPECTION COPY (INITIAL): PINK OWNER COPY (INITIAL): GOLD

# IREDELL COUNTY HEALTH DEPARTMENT

VILLE NC 878-5305 MOORESVILLE 704-664-5281

## IMPROVEMENT PERMIT / CERTIFICATE OF COMPLETION / OPERATION PERMIT / EXISTING SYSTEM INSPECTION

PROPERTY DESCRIPTION NO. Repair DATE 1/30/96 TAX MAP NO. N/A

OWNER OR CONTRACTOR James A Tate PHONE: Business Watershed: ☐ Yes ☒ No

ADDRESS 112 Keller Ridge Rd. Mooresville NC 28115 Home 664-2208

LOCATION 115-21 S TR Four Square Rd. TL Keller Ridge Ln, 2nd house on (R) ± 112

SUBDIVISION BLOCK / SECTION LOT Exist. LOT AREA SITE CLASS. DESIGN FLOW 240 L.T.A.R. .25

Septic Tank: Gallons; STB Date

Pump Tank: Gallons; PT Date

Pump Make: Model Serial No.

Nitrification Field: No Fields 1 Square Feet 1000 Linear Feet 300

No Lines 3 Trench Width 10' Max Trench Bottom Depth 30" Gravel Depth 12"

☐ New System ☒ Repair System Type: I II III IV V VI

System Description: GRAV. BED

Repair System Description:

Maintenance Agreement Required: ☐ Yes ☒ No

☒ House/Mod. Home No. Bedrooms 2

☐ Mobile Home No. Bathrooms 1

☐ Business No. Employees

☐ Other

☐ Slab ☒ Crawl Space ☐ Basement w/plumbing ☐ Basement wo/plumbing


Water Supply: ☒ Individual ☐ Community ☐ Public

Comments:

Comments:

Installed 70'x15' bed as drawn on Impr. Permit

INITIAL SITE SKETCH

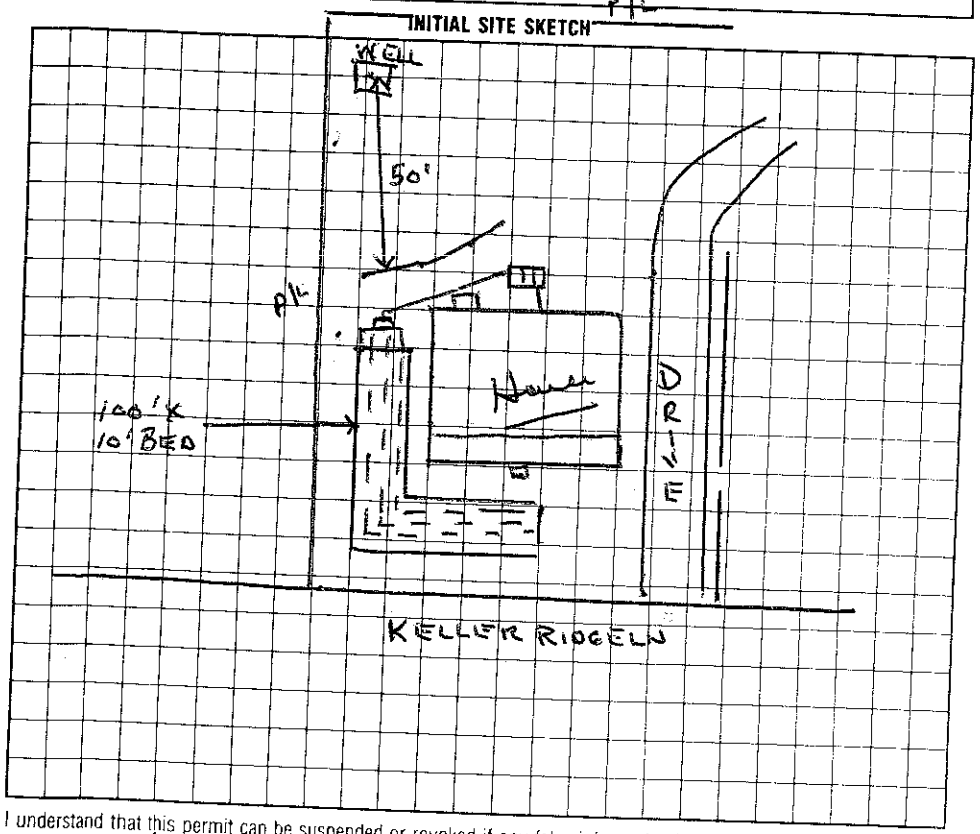


AS BUILT SKETCH

I understand that this permit can be suspended or revoked if any false information is supplied toward securing the permit/any unauthorized changes are made to the site/any unauthorized changes are made in the installation of the system.

Signed: ☒ James A Tate

Improvement Permit by: date

Existing System Inspection by: Keith W Grantham Wesley Sparks RS. date 1/30/96

Installed by: Julian Bowles

Certificate of Completion by: date

Operation Permit by: Wesley Sparks RS. date 4/11/97

HEALTH DEPT. COPY: WHITE INSPECTION COPY (FINAL): GREEN OWNER COPY (FINAL): YELLOW INSPECTION COPY (INITIAL): PINK OWNER COPY (INITIAL): GOLD