IREDELL COUNTY HEALTH DEPARTMENT

STATESVILLE 704-878-5305 MOORESVILLE 704-664-5281

IMPROVEMENT PERMIT / AUTHORIZATION TO CONSTRUCT / OPERATION PERMIT / EXISTING SYSTEM INSPECTION

PERMIT# 6696 PIN# 4656439904 DATE 6/14/99

OWNER OR CONTRACTOR Homer Bumgarner PHONE: Business Home 663-5321

ADDRESS 1121 Mecklenburg Hwy Mooresville NC

LOCATION Hwy 115 S. 4 house past Shop & Save

SUBDIVISION BLOCK / SECTION LOT 8 LOT AREA .854 Acre SITE CLASS. DESIGN FLOW L.T.A.R.

Septic Tank: Existing Gallons: STB Date

Pump Tank: Gallons: PT Date

Pump Make: Model Serial No.

Nitrification Field: No Fields Existing Square Feet Linear Feet

No Lines Trench Width Existing Max Trench Bottom Depth Existing Gravel Depth

☐ New System ☐ Repair System Type: I II III IV V VI

System Description: Existing System

Repair System Description:

Maintenance Agreement Required: ☐ Yes ☐ No

☒ House/Mod. Home No. Bedrooms 2

☐ Mobile Home No. Bathrooms 1.5

☐ Business No. Employees

☐ Other

☐ Slab ☒ Crawl Space ☐ Basement w/plumbing ☐ Basement wo/plumbing


Water Supply: ☒ Individual ☐ Public ☐ Community

Comments:/Conditions: Keeping building at least 5' from any part of Septic System

Comments:/Conditions: Existing Septic System appears to be functioning okay at time of inspection, no problems noticed

NOT TO SCALE

INITIAL SITE SKETCH

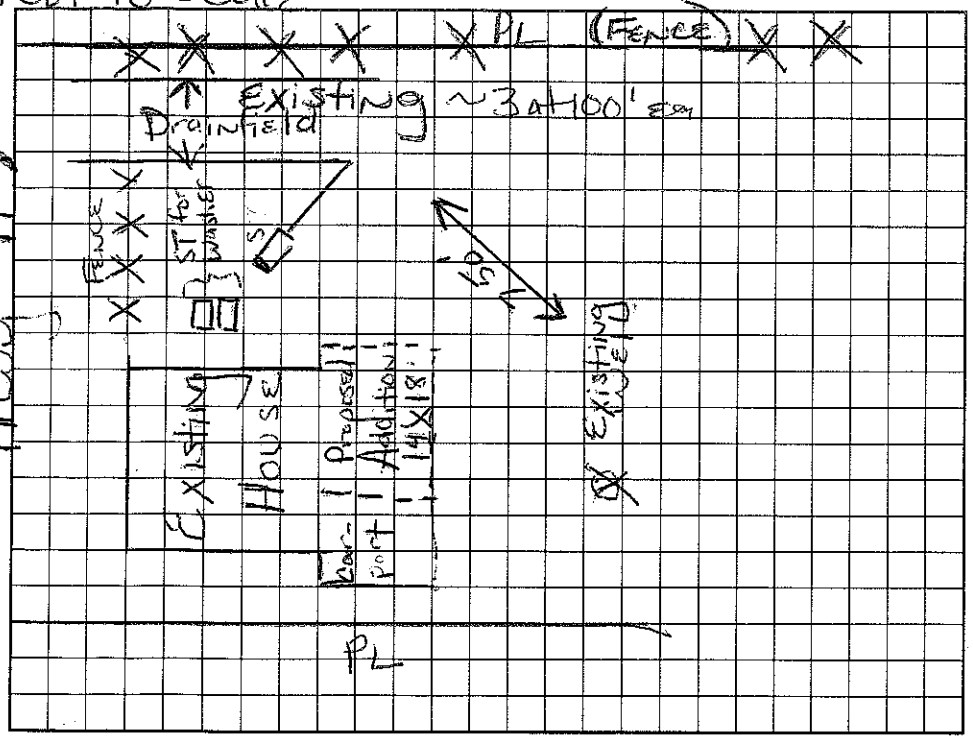

AS BUILT SKETCH

Permit can be suspended or revoked if any false information is supplied toward securing the permit/any unauthorized changes are made to the site/any unauthorized changes are made in the installation of the system. Improvement Permit with plat valid without expiration. Improvement Permit with site plan valid for sixty months. Authorization to Construct is valid for a period equal to that of Improvement Permit – not to exceed sixty months.

Signed: Homer M. Bumgarner date Installed by:

Improvement Permit by: Maina H. Watson R.S. date 6/14/99 Operation Permit by: date

Authorization to Construct by: date Existing System Inspection by: Maina H. Watson R.S. date 6/14/99

HEALTH DEPT. COPY: WHITE OWNER COPY (FINAL): YELLOW OWNER COPY (INITIAL): PINK