11:30

IREDELL COUNTY HEALTH DEPARTMENT

STATESVILLE 704-878-5305 MOORESVILLE 704-664-5281

IMPROVEMENT PERMIT / AUTHORIZATION TO CONSTRUCT / OPERATION PERMIT / EXISTING SYSTEM INSPECTION

PERMIT# 52 524 PIN# 4656440099 DATE 1-6-98

OWNER OR CONTRACTOR Gary Snow PHONE: Business Paul Sprinkle 662-8434 Home 662-8436

ADDRESS 121 E Park Ave Mooresville NC 28115

LOCATION 115 S to Foursquare Rd. - lot btw 2 Brick Houses past Church on left

SUBDIVISION _____ BLOCK / SECTION _____ LOT _____ LOT AREA 1.0 Acre SITE CLASS. _____ DESIGN FLOW 480gpd L.T.A.R. .3+

Septic Tank Existing 1000 Gallons; STB _____ Date _____

Pump Tank: _____ Gallons; PT _____ Date _____

Pump Make: _____ Model _____ Serial No. _____

Nitrification Field: No Fields 1 Square Feet 300' Linear Feet 100'

No Lines 2 at 50' ea Trench Width 36" Max Trench Bottom Depth 36" Gravel Depth 12"

☐ New System ☒ Repair System Type: I (II) III, IV, V, VI

System Description: Gravity-Conventional Bed

Repair System Description: Grav-Conventional

Maintenance Agreement Required: ☐ Yes ☒ No

☐ House/Mod. Home No. Bedrooms 4

☒ Mobile Home No. Bathrooms 2.5

☐ Business No. Employees _____

☐ Other _____

☐ Slab ☒ Crawl Space ☐ Basement w/plumbing ☐ Basement wo/plumbing


Water Supply: ☒ Individual ☐ Public ☐ Community

Upgrade

Comments:/Conditions: Install D-Box & Set Box So Existing Bed is Fed First & 2 Additional lines are fed equally next. Keep well at least 50' from Septic System. (Existing Bed 7½ x 75' - Functioning ok.)

Comments:/Conditions: Building Inspection Dept. Please Collect Total Fees due to Health Dept. = $175.00 (Upgrade From 2 Bedroom to 4 Bedroom)

INITIAL SITE SKETCH Scale ~ 1:60

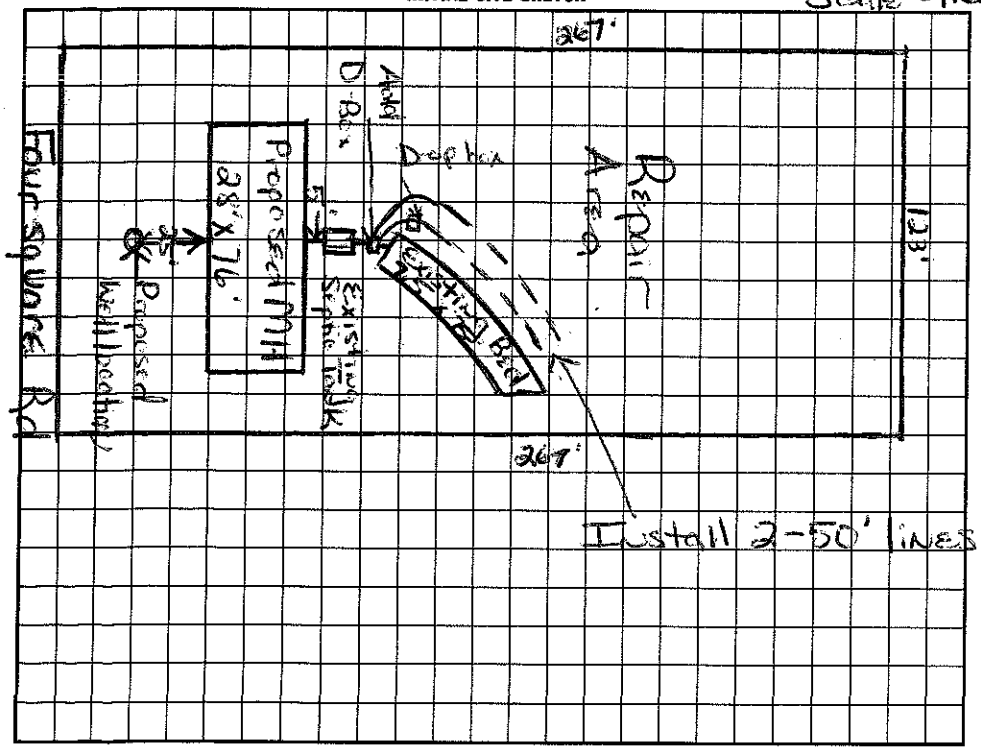

AS BUILT SKETCH

Installed As Shown

Well Not installed at time of Inspection

I understand that this permit can be suspended or revoked if any false information is supplied toward securing the permit/any unauthorized changes are made to the site/any unauthorized changes are made in the installation of the system. Improvement Permit with plat valid without expiration. Improvement Permit with site plan valid for sixty months. Authorization to Construct is valid for a period equal to that of Improvement Permit – not to exceed sixty months.

Signed: Paul Sprinkle Agent date _____

Improvement Permit by: Maria H. Dotson date 1/6/97

Authorization to Construct by: Maria H. Dotson date 1/6/97

Installed by: Tweed Grading - Morganton

Operation Permit by: Maria H. Dotson date 11/3/98

Existing System Inspection by: Maria H. Dotson date 11/13/98

HEALTH DEPT. COPY: WHITE INSPECTION COPY (FINAL): GREEN OWNER COPY (FINAL): YELLOW INSPECTION COPY (INITIAL): PINK OWNER COPY (INITIAL): GOLD