IREDELL COUNTY HEALTH DEPARTMENT

Statesville Phone TR 3-7271 Mooresville Phone NO 3-1271

PERMIT TO INSTALL SEPTIC TANK

Permit NO. _____ Permit Date 30 June 1970

Owner Larry Sloop Address Mooresville N C

Installed By Erwin Address Mooresville N C


Location of Property _____

Tank		Capacity		Length of Lines		Fixtures	
Block	( )	1000	( )	225'	(✓)	No. of Baths	( )
Precast	(✓)	1250	( )	250'	( )	Dishwasher	( )
		1500	( )	Other _____		Garbage Grdr.	( )
		Other _____				Other _____	

NOTIFY HEALTH DEPARTMENT AT LEAST EIGHT HOURS BEFORE TANK IS TO BE INSPECTED.

Final Inspection 30 June 1970 Approved (✓) Disapproved ( )

Remarks Water from next door

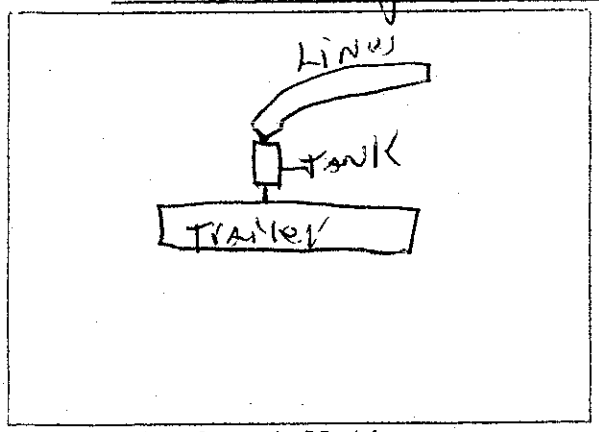

Sketch of Installation

Irvin R. Ferguson, RS

Sanitarian