4656442273

IREDELL COUNTY HEALTH DEPARTMENT

STATESVILLE 704-878-5305 MOORESVILLE 704-664-5281

IMPROVEMENT PERMIT / CERTIFICATE OF COMPLETION / OPERATION PERMIT / EXISTING SYSTEM INSPECTION

PROPERTY DESCRIPTION NO. 2677 DATE Feb 28, 94 TAX MAP NO. I-J26A Watershed: ☐ Yes ☐ No

OWNER OR CONTRACTOR Jerry Styers PHONE: Business _____ Home _____

ADDRESS RTS Box 3104 Boone, NC 28607

LOCATION 115 S. TR Foursquare Rd. on Right just past 1st Existing house

SUBDIVISION _____ BLOCK / SECTION _____ LOT C LOT AREA 30,000 ft²+ SITE CLASS. PS DESIGN FLOW 450 gpd L.T.A.R. .25 - .3

Septic Tank: 1500 Gallons; STB _____ Date _____

Pump Tank: _____ Gallons; PT _____ Date _____

Pump Make: _____ Model _____ Serial No. _____

Nitrification Field: No Fields 1 Square Feet 1800 + Linear Feet 600

No Lines 5 Trench Width 36" Max Trench Bottom Depth 24" Gravel Depth _____

☑ New System ☐ Repair System Type: I, ☐ II, III, IV, V, VI

System Description: Gravity conventional

Repair System Description: Same

Maintenance Agreement Required: ☐ Yes ☑ No

☑ House/Mod. Home No. Bedrooms 4

☐ Mobile Home No. Bathrooms 4

☐ Business No. Employees ____

☐ Other Duplex


☐ Slab ☑ Crawl Space ☐ Basement w/plumbing ☐ Basement wo/plumbing

Water Supply: ☑ Individual ☐ Community ☐ Public


Comments: Keep nitrification trenches shallow 18-24" +6 depth.

Comments:

INITIAL SITE SKETCH

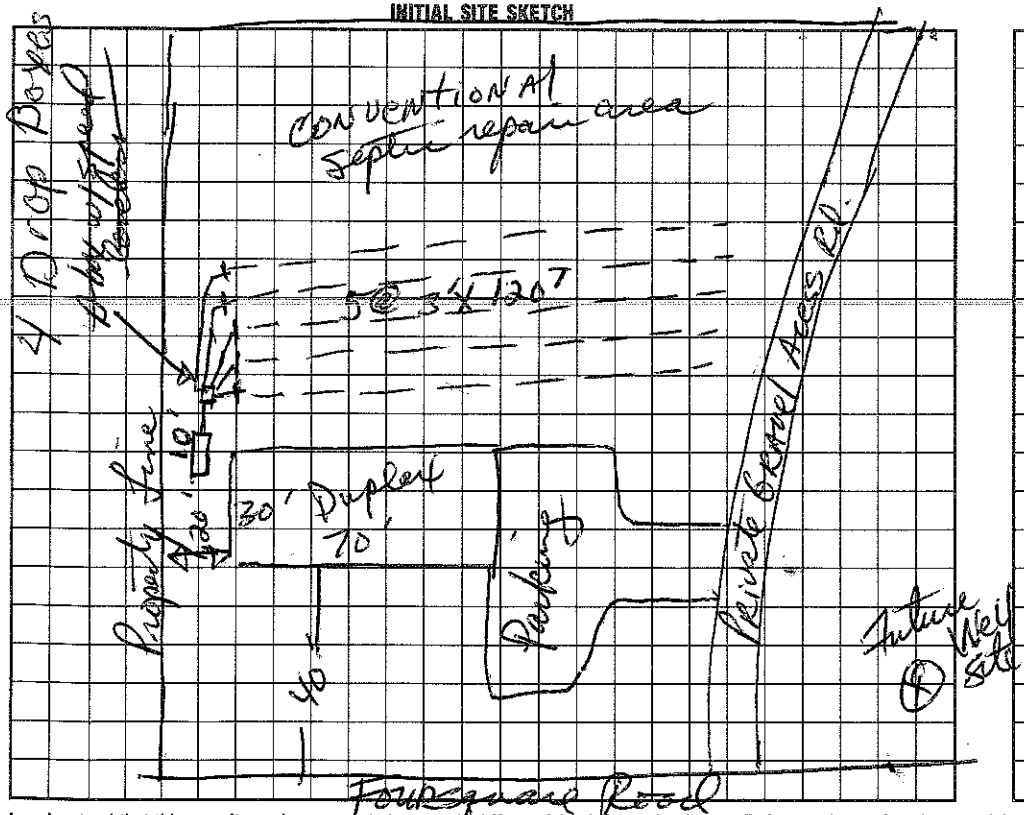

AS BUILT SKETCH

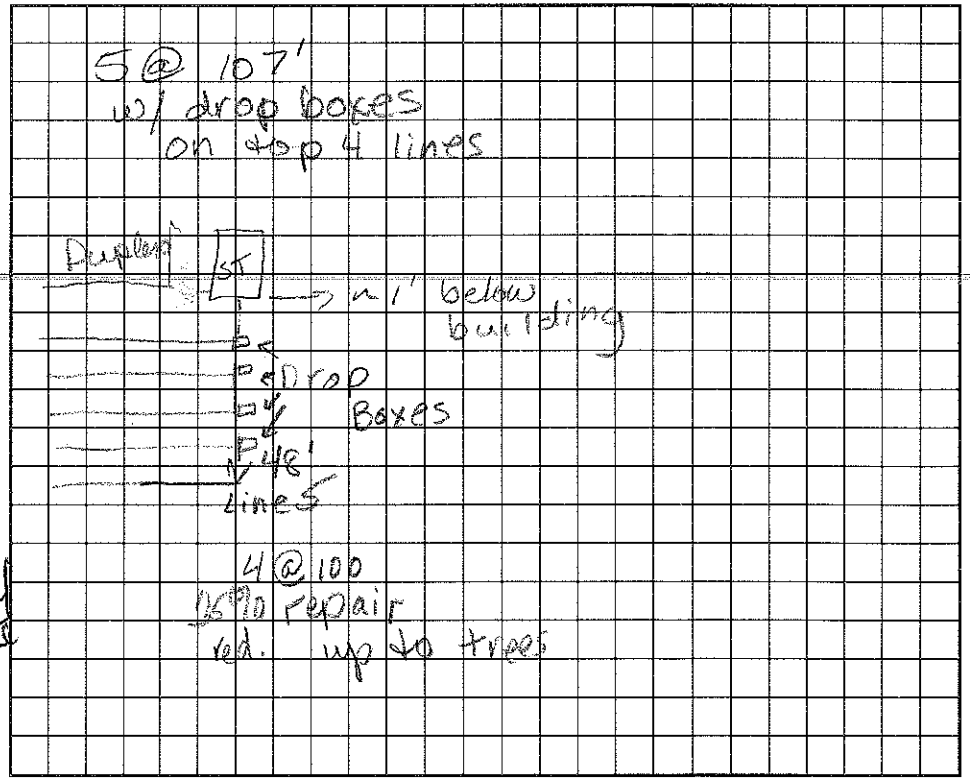

I understand that this permit can be suspended or revoked if any false information is supplied toward securing the permit/any unauthorized changes are made to the site/any unauthorized changes are made in the installation of the system. Improvement Permit is valid for 60 months from date of issuance.

Signed: X Jerry Styers

Improvement Permit by: Jack Hanson, RS date 2/28/94

Existing System Inspection by: _____ date _____

Installed by: _____

Certificate of Completion by: _____ date _____

Operation Permit by: _____ date _____

HEALTH DEPT. COPY: WHITE INSPECTION COPY (FINAL): GREEN OWNER COPY (FINAL): YELLOW INSPECTION COPY (INITIAL): PINK OWNER COPY (INITIAL): GOLD