4656445188 DON INNIS

IREDELL COUNTY HEALTH DEPARTMENT

STATESVILLE 704-878-5305 MOORESVILLE 704-664-5281

IMPROVEMENT PERMIT / CERTIFICATE OF COMPLETION / OPERATION PERMIT / EXISTING SYSTEM INSPECTION

PROPERTY DESCRIPTION NO. 2671 DATE Feb 28, '94 TAX MAP NO. 1J26A Watershed: ☐ Yes ☐ No

OWNER OR CONTRACTOR Jerry Styers PHONE: Business _____ Home _____

ADDRESS RT 5 Box 340, Boone, NC 28607

LOCATION 115 S. TR Foursquare Rd. 1st Lot on Right

SUBDIVISION _____ BLOCK / SECTION _____ LOT A 1 LOT AREA 30,000+ ft² + SITE CLASS. PS DESIGN FLOW 480 gpd L.T.A.R. e 3

Septic Tank: 1500 Gallons; STB 791 Date 1200

Pump Tank: _____ Gallons; PT _____ Date _____

Pump Make: _____ Model _____ Serial No. _____

Nitrification Field: No Fields 2 Square Feet 1600+ Linear Feet 540

No Lines 3+3 Trench Width 36 Max Trench Bottom Depth 24" Gravel Depth _____

☑ New System ☐ Repair System Type: I, II, III, IV, V, VI

System Description: gravity conventional

Repair System Description: Grav or pumped conv.

Maintenance Agreement Required: ☐ Yes ☐ No

☑ House/Mod. Home No. Bedrooms 4

☐ Mobile Home No. Bathrooms 4

☐ Business No. Employees _____

☐ Other _____


☐ Slab ☑ Crawl Space ☐ Basement w/plumbing ☐ Basement wo/plumbing

Water Supply: ☑ Individual ☐ Community ☐ Public

Comments: Exit plumbing At existing grade. @ Existing Well

Comments:

INITIAL SITE SKETCH

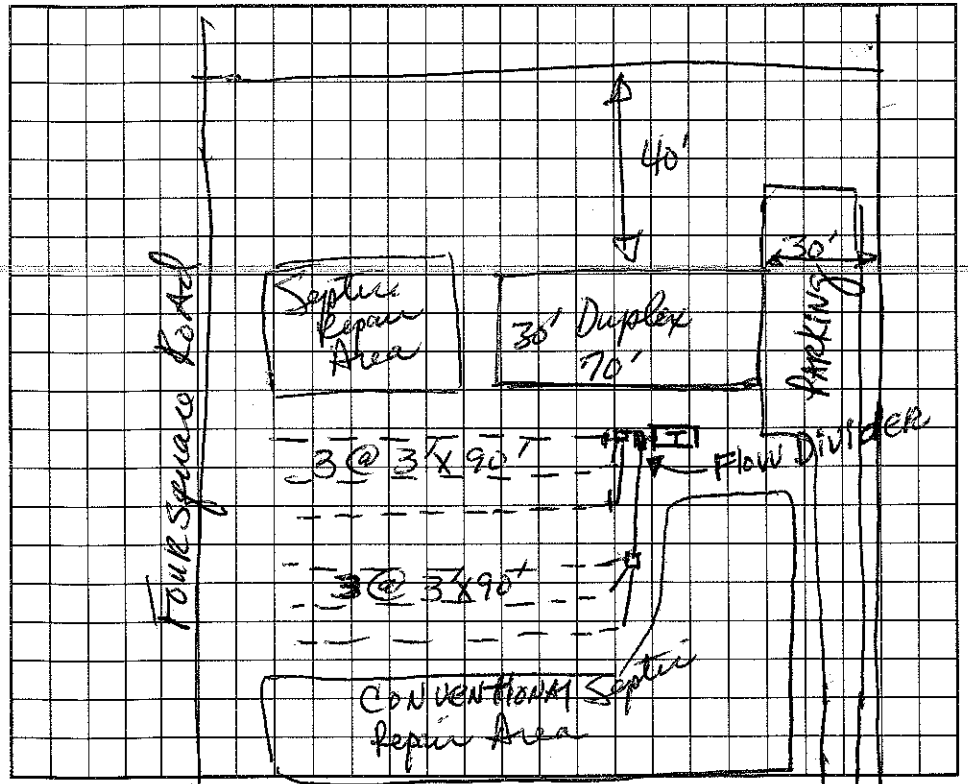

AS BUILT SKETCH

I understand that this permit can be suspended or revoked if any false information is supplied toward securing the permit/any unauthorized changes are made to the site/any unauthorized changes are made in the installation of the system. Improvement Permit is valid for 60 months from date of issuance. Private Access Road (Estelle Rd.)

Signed: Jerry Styers

Improvement Permit by: David R. Hinson, RS date 2/28/94

Existing System Inspection by: _____ date _____

Installed by: B I R - Codyco

Certificate of Completion by: Wesley Sparks R.S. date 6/29/95

Operation Permit by: _____ date _____

HEALTH DEPT. COPY: WHITE INSPECTION COPY (FINAL): GREEN OWNER COPY (FINAL): YELLOW INSPECTION COPY (INITIAL): PINK OWNER COPY (INITIAL): GOLD