IREDELL COUNTY HEALTH DEPARTMENT

STATESVILLE 704-878-5305 MOORESVILLE 704-664-5281

IMPROVEMENT PERMIT / AUTHORIZATION TO CONSTRUCT / OPERATION PERMIT / EXISTING SYSTEM INSPECTION

PERMIT# 122380 PIN# 4656-51-7878.1 DATE 7/14/04

OWNER OR CONTRACTOR BRETT MUELLER PHONE: Business 704-202-4955 Home

ADDRESS 208 MACKWOOD RD

LOCATION 115 SOUTH - TL MACKWOOD RD - ON RT @ 208

SUBDIVISION BLOCK / SECTION LOT LOT AREA .976AC SITE CLASS. PS DESIGN FLOW 360 L.T.A.R. EXISTING

Septic Tank: 1000-EXISTING Gallons; STB Date

Pump Tank: Gallons; PT Date

Pump Make: Model Serial No.

Nitrification Field: No Fields 1 Square Feet 562.5 Linear Feet @ 75x7½

No Lines 3 @ 75' Trench Width 7½' Max Trench Bottom Depth Gravel Depth

☑ New System ☐ Repair System Type: I, (II), III, IV, V, VI

System Description: GRAVITY CONVENTIONAL

Repair System Description:

Maintenance Agreement Required: ☐ Yes ☑ No

☑ House/Mod. Home No. Bedrooms 3

☐ Mobile Home No. Bathrooms 2

☐ Business No. Employees

☐ Other


☐ Slab ☑ Crawl Space ☐ Basement w/plumbing ☐ Basement wo/plumbing

Water Supply: ☑ Individual ☐ Public ☐ Community


Comments:/Conditions: ADDING NEW GARAGE + SYSTEM FT², LINEAR FEET & # OF LINES COMES FROM OLD PERMIT. + SYSTEM FUNCTIONING PROPERLY AT TIME OF INSPECTION

Comments:/Conditions:

INITIAL SITE SKETCH — MILLER 110 LOW LANE 1"=40'

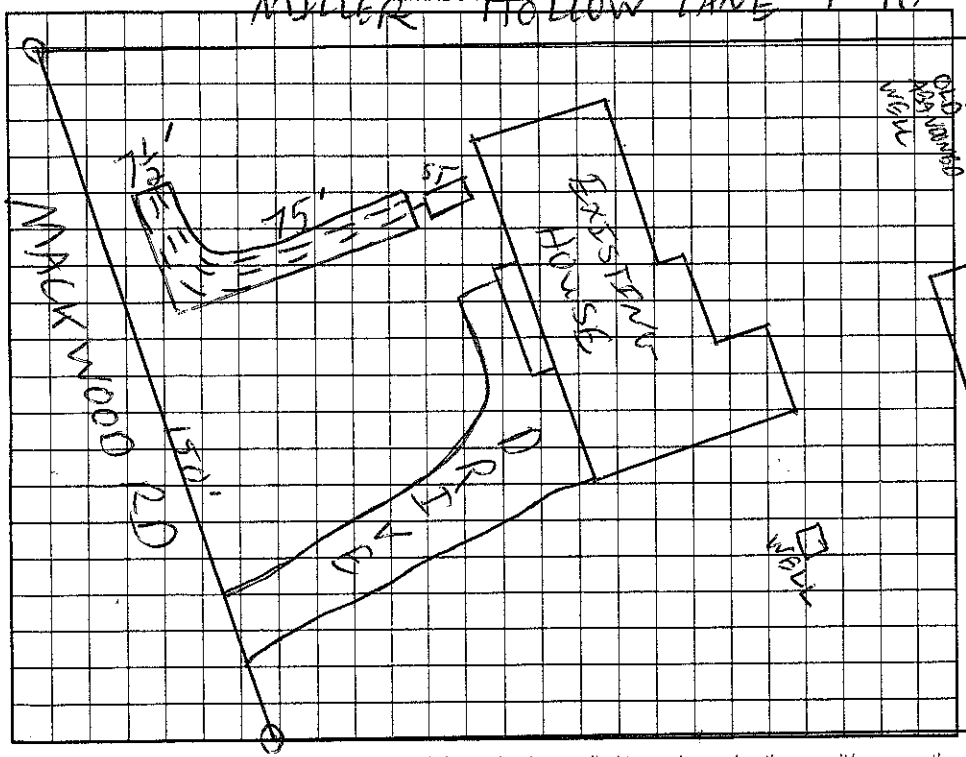

AS BUILT SKETCH

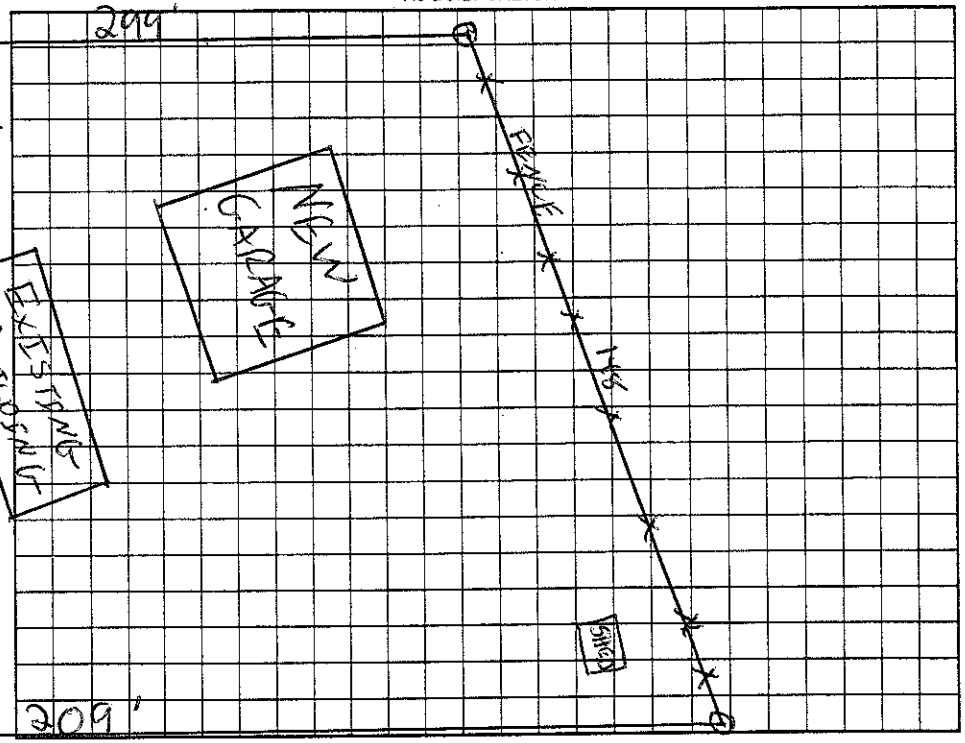

Permit can be suspended or revoked if any false information is supplied toward securing the permit/any unauthorized changes are made to the site/any unauthorized changes are made in the installation of the system. Improvement Permit with plat valid without expiration. Improvement Permit with site plan valid for sixty months. Authorization to Construct is valid for a period equal to that of Improvement Permit – not to exceed sixty months.

Signed: B. Mueller date 7/20/04 Installed by:

Improvement Permit by: date Operation Permit by: date

Authorization to Construct by: date Existing System Inspection by: C. Mc RS date 7/20/04

HEALTH DEPT. COPY: WHITE OWNER COPY (FINAL): YELLOW OWNER COPY (INITIAL): PINK