IREDELL COUNTY HEALTH DEPARTMENT

Statesville Phone TR 3-7271 Mooresville Phone No. 664-5281

PERMIT TO INSTALL SEPTIC TANK

Permit No. 237 Permit Date 9-19-1973

Owner Ronnie Honeycutt Address Mooresville

Installed By F. J. Ervin Address Mooresville

Location of Property ~~4~~ N.C. 115 South


To on 1128 ~~4~~ mi on right

Tank		Capacity		Length of Lines		Fixtures	
Block	( )	1000	(✓)	225'	(✓)	No. of Baths	(2)
Precast	(✓)	1250	( )	250'	( )	Dishwasher	(no)
		1500	( )	Other		Garbage Grdr.	(no)
		Other				Other Washing Machine	

NOTIFY HEALTH DEPARTMENT AT LEAST EIGHT HOURS BEFORE TANK IS TO BE INSPECTED.

Final Inspection 9-19-1973 Approved (✓) Disapproved ( )

Remarks

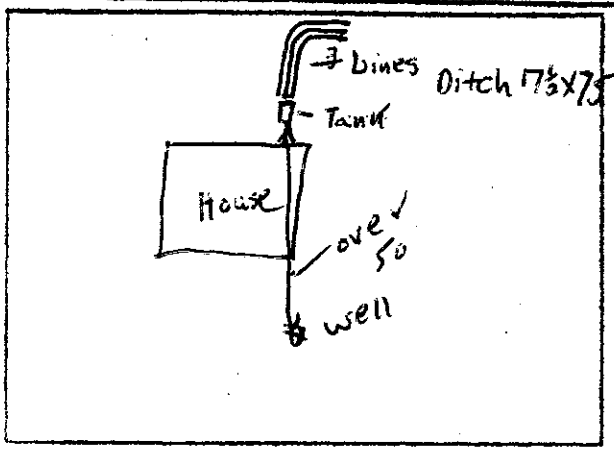

Sketch of Installation

A. C. Moore