4656526899

IREDELL COUNTY HEALTH DEPARTMENT Const. Auth. STATESVILLE 704-878-5305 MOORESVILLE 704-664-5281

IMPROVEMENT PERMIT / ~~CERTIFICATE OF COMPLETION~~ / OPERATION PERMIT / EXISTING SYSTEM INSPECTION

PROPERTY DESCRIPTION NO. _____ DATE Aug 21, '96 TAX MAP NO. _____ Watershed: ☐ Yes ☐ No

OWNER OR CONTRACTOR Hazel Jordan PHONE: Business _____ Home 663-6210

ADDRESS 141 Stacy Road

LOCATION 1153 & TL Markwood Rd. TL Stacy Rd. at end TL top of hill

SUBDIVISION _____ BLOCK / SECTION _____ LOT _____ LOT AREA _____ SITE CLASS. _____ DESIGN FLOW 240 gpd L.T.A.R. n.3

Septic Tank: 1000 Gallons; STB 794 Date 4/23/96

Pump Tank: _____ Gallons; PT _____ Date _____

Pump Make: _____ Model _____ Serial No. _____

Nitrification Field: No Fields 1 Square Feet 600 Linear Feet 200

No Lines ~~4~~ (4) Trench Width 12"x24" Max Trench Bottom Depth ~36" Gravel Depth 12"+

☐ New System ☑ Repair System Type: I, (II), III, IV, V, VI

System Description: gravity conv. bed

Repair System Description: _____

Maintenance Agreement Required: ☐ Yes ☐ No

☑ House/Mod. Home No. Bedrooms 2

☐ Mobile Home No. Bathrooms 2

☐ Business No. Employees _____

☐ Other _____


☐ Slab ☑ Crawl Space ☐ Basement w/plumbing ☐ Basement wo/plumbing

Water Supply: ☑ Individual ☐ Community ☐ Public

Comments: This system is for the sink, washing machine and shower that are presently going into a pit.

Comments:

INITIAL SITE SKETCH

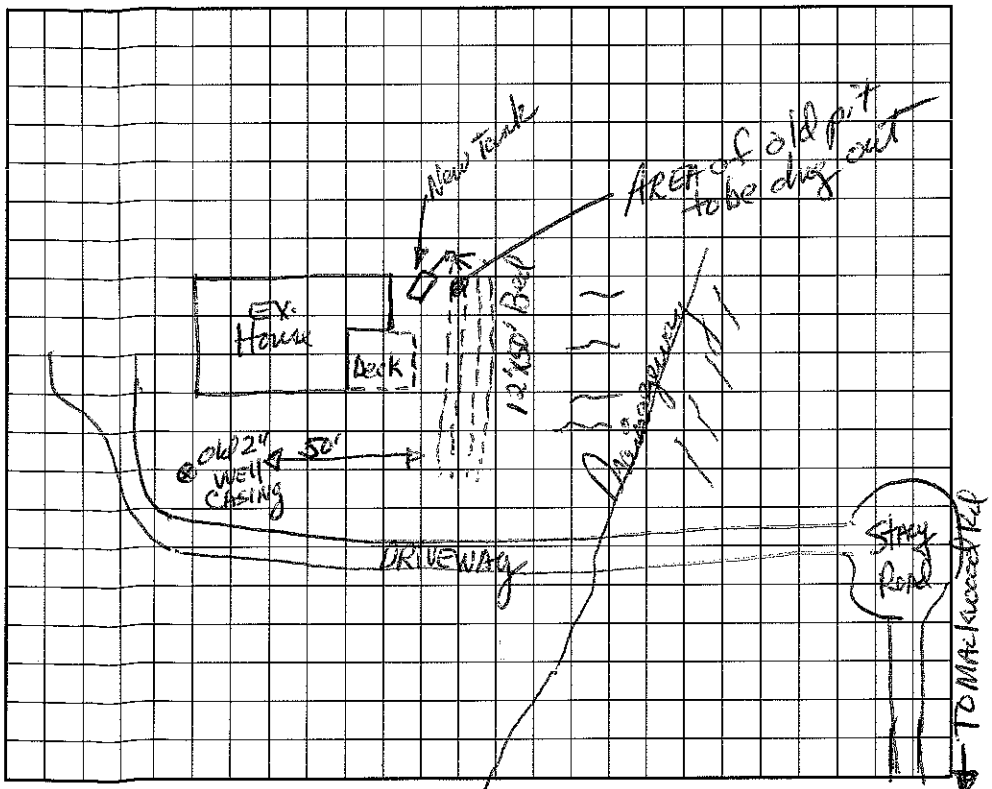

AS BUILT SKETCH

I understand that this permit can be suspended or revoked if any false information is supplied toward securing the permit/any unauthorized changes are made to the site/any unauthorized changes are made in the installation of the system.

Signed: Hazel Jordan

Improvement Permit by: J. Hinson RS date 8-21-96

~~Existing System Inspection by:~~ Construction Authorization by: J. Hinson RS date 8-21-96

Installed by: Julian Bowles

Certificate of Completion by: _____ date _____

Operation Permit by: Wesley Sparks R.S. date 9/11/96

HEALTH DEPT. COPY: WHITE INSPECTION COPY (FINAL): GREEN OWNER COPY (FINAL): YELLOW INSPECTION COPY (INITIAL): PINK OWNER COPY (INITIAL): GOLD