4656536331

IREDELL COUNTY HEALTH DEPARTMENT

Authorization to Construct

2:30

STATESVILLE 704-878-5305 MOORESVILLE 704-664-5281

IMPROVEMENT PERMIT / ~~CERTIFICATE OF COMPLETION~~ / OPERATION PERMIT / EXISTING SYSTEM INSPECTION

PROPERTY DESCRIPTION NO. 4690 DATE 6/16/97 TAX MAP NO. 4656536331 Watershed: ☐ Yes ☒ No

OWNER OR CONTRACTOR E J Ervin PHONE: Business _____ Home 664-5418

ADDRESS 380 Mahaffey Rd. Mooresville, NC. 28115

LOCATION Klutz Rd. to end on (R) off 115 on left

SUBDIVISION _____ BLOCK / SECTION _____ LOT _____ LOT AREA 2.049 SITE CLASS. PS DESIGN FLOW 360 L.T.A.R. .3

Septic Tank: 1000 Gallons; STB 794 Date 6-6-94

Pump Tank: _____ Gallons; PT _____ Date _____

Pump Make: _____ Model _____ Serial No. _____

Nitrification Field: No Fields 1 Square Feet 150 Linear Feet 40

No Lines 2 Trench Width 3' Max Trench Bottom Depth 36" Gravel Depth 12"

☐ New System ☒ Repair, System Type: I (II) III, IV, V, VI

System Description: Adding to engineered system

Repair System Description: _____

Maintenance Agreement Required: ☐ Yes ☐ No

☐ House/Mod. Home No. Bedrooms 3

☐ Mobile Home No. Bathrooms 1

☐ Business No. Employees _____

☐ Other _____


☐ Slab ☒ Crawl Space ☐ Basement w/plumbing ☐ Basement wo/plumbing

Water Supply: ☒ Individual ☐ Community ☐ Public

Comments:

Comments:

INITIAL SITE SKETCH

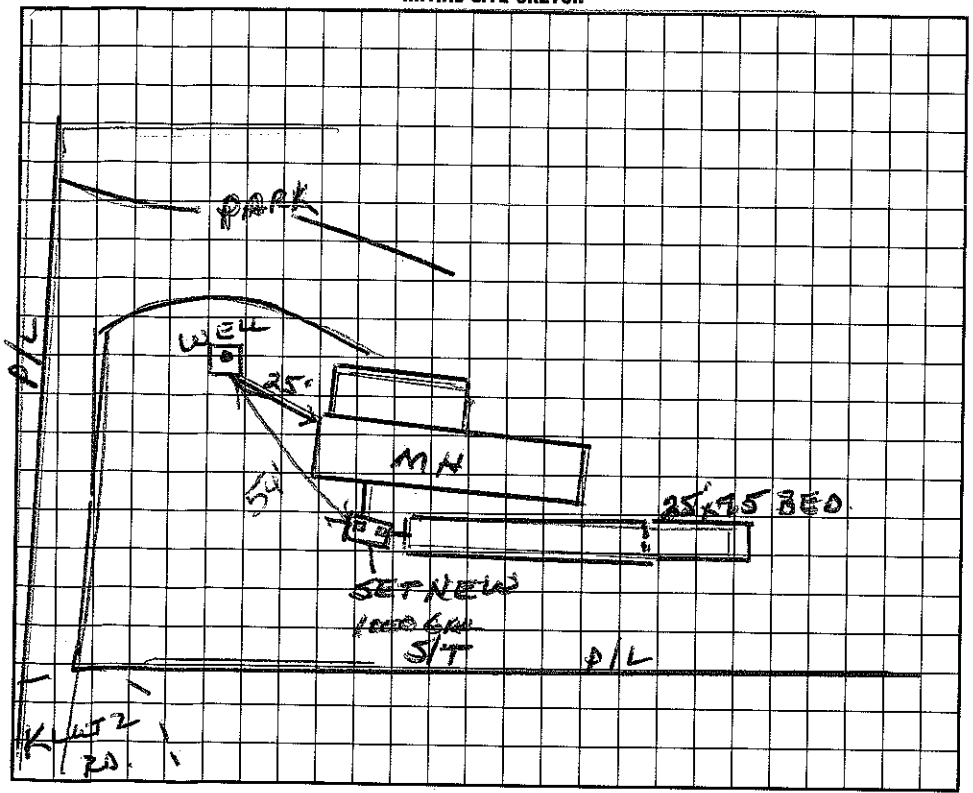

AS BUILT SKETCH

I understand that this permit can be suspended or revoked if any false information is supplied toward securing the permit/any unauthorized changes are made to the site/any unauthorized changes are made in the installation of the system. Improvement Permit is valid for 60 months from date of issuance.

Signed: ✱ Jim Nance

Improvement Permit by: Wesley Sparks R.S. date 6/16/97

~~Certificate of Completion~~ Existing System Inspection by: Wesley Sparks R.S. date 6/16/97

Installed by: E.J. Ervin

Certificate of Completion by: Maria H.H. Dalton date 7/25/97

Operation Permit by: Maria H.H. Dalton date 7/25/97

HEALTH DEPT. COPY: WHITE INSPECTION COPY (FINAL): GREEN OWNER COPY (FINAL): YELLOW INSPECTION COPY (INITIAL): PINK OWNER COPY (INITIAL): GOLD